

LEGEND
 48" iron pin set (●)
 Monument Fd. (○)
 Data of record ()



REGISTERED
 OREGON
 LAND SURVEYOR
S. Kendrick Ford
 JULY 10, 1964
 S. KENDRICK FORD
 642

SURVEY FOR
 WALTER C. FLETCHER
 SW 1/4 - Sec. 20 - T35S - R3W - W.M.
 by
 Stephen H. Ford & Assoc.'s
 795 Willamette Street
 Eugene, Oregon
 Scale: 1"=200' Dec., 1971

Survey Narrative to Comply with O.R. S. 209.250

FOR Walter C. Fletcher
745 Arcadia Drive
Eugene, Oregon

PURPOSE: 1. To survey and monument the east one-half of the southwest one-quarter of Section 20, Township 35 South, Range 3 West of the Willamette Meridian.

PROCEDURE: Found B.L.M. Brass discs at the following corners:
Section corner common to Sections 19, 20, 29, and 30.
Witness Corner to northwest corner of the southwest one-quarter of the southwest one-quarter of Section 20.
One-quarter corner between Sections 19 and 20. One-quarter corner between Sections 17 and 20.

Found one-inch pipe at the one-quarter corner between Sections 20 and 21 and verified by two original bearing trees.



Found two-inch pipe at the Section corner common to Sections 20, 21, 28, and 29 and verified by bearing trees.

At the one-quarter corner between Sections 20 and 29, I set, by proportion, a 5/8-inch X 2 1/2-inch iron pin, from which a 10-inch pine, scribed 1/4 S 20-RE 302 1/4, bears N 43° E 31.6 feet and a 20-inch pine, scribed 1/4 S 29-RE 302 1/4, bears S 48 1/2° E 26.9 feet.

Enough monuments, 5/8-inch iron pins were found to re-monument the County Road in its proper location.

From the found and set control points, 5/8-inch and 2 1/2-inch iron pins were set as shown on the map to accompany this report.

December 30, 1971

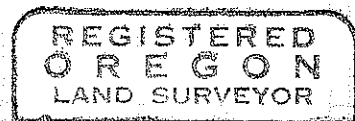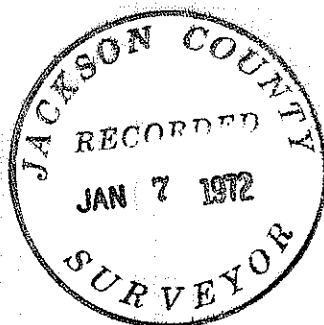

S. Kendrick Ford

