

REGISTERED
 OREGON
 LAND SURVEYOR

Edward A. McGinty


JULY 10, 1963
 EDWARD A. MCGINTY
 301

SURVEY LOCATION
EHRMAN WAREHOUSE INDUSTRIAL DISTRICT
SE 1/4 SEC.14 T.37S. R2 W. W.M.

FOR
 Cecil Saxton
 71-36

BY EDWARD MC GINTY
 MEDFORD OREGON
 OCT 1971

SCALE 1" = 100'
 ○ = 3/4" I. PIPE
 ◦ = 5/8" I. PIN

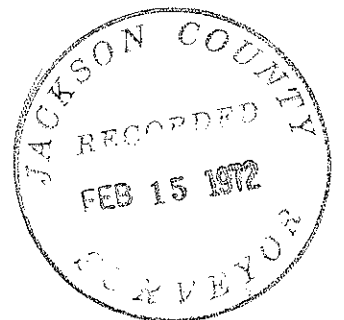

Survey No. 4781

SURVEY NARRATIVE TO COMPLY WITH O.R.S. 209-250

Survey for: Mr. Cecil Saxon 71-36
2837 Willamette
Eugene, Oregon 97401

Survey by: Edward A. McGinty, R.S.
Medford, Oregon
November, 1971

Location: SE. 1/4 of Sec. 14, T37S, R2W
EHRMAN WAREHOUSE INDUSTRIAL DIST.

Precedence of Survey:

At request of client, surveyed tract as shown.

The westerly line being a division line created or shown on survey No. 2134. Survey No. 3507 was a retracement. This survey is also a partial retracement of the same line.

Monuments found being 5/8 in. iron pins, averaging approx. 0.3 ft. deep. (note found 5/8 in. iron pins set next to corner monuments, by person unknown to me, apparently to find the corner location)

Monuments set being 5/8 x 24 in. iron pins, approx. flush with the surface.

