

SURVEY IN NE 1/4 SEC 6 T38S R2W WM

FOR

ROBERT W. HAWKINS

72-4



BY EDWARD MCGINTY

SCALE 1" = 100'

MEDFORD OREGON

o = SET 5/8" I. PIN

FEB. 1972

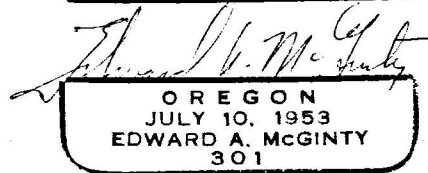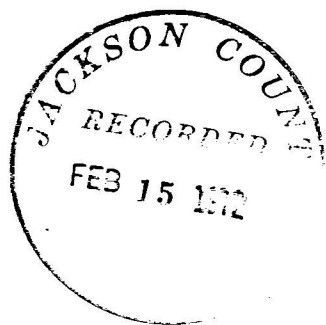





























SURVEY NO. _____

4785

SURVEY NARRATIVE TO COMPLY WITH O.R.S. 209-250

Survey for: Mr. Robert Hawkins
208 Summit Ave.
Medford, Oregon

Survey by: Edward A. McGinty, R.S.
Medford, Oregon
Feb. 1972

Basis of Bearing: Previous Survey



Location: NW X NE Sec. 6, T38S, R2W

Precedence of Survey:

From previous survey datum traversed along the North line of the Section. Traversed center line of existing traveled county road. Computed intersection of description furnished by client. Note: corners along county road are 30 feet from center line of traveled county road.

Monuments set being 5/8 in. iron pins and set approx. flush with the surface. 1/4 corner being 1 in. pipe and brass cap set by county surveyor.

72-4

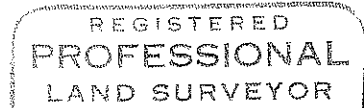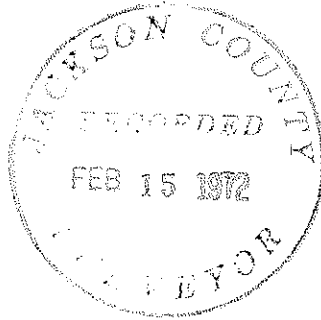

Edward A. McGinty

OREGON
JULY 10, 1953
EDWARD A. MCGINTY
301