

4786

NE COR D.L.C. 38

S.N. 3186

1888.36'

50°20'50"W

ROAD

60'

CHINA GULCH

756.16'

N0°20'50"E

Δ = 0°17'13"  
R = 5729.58'  
L = 2869'

S87°01'20"W

331.56'

STATE HWY. 238

S03°29'15"W

736.44'

APPROX. NLY R/W

S87°01'20"W

316.00'

N89°39'10"W

698.53'

728.66'

Δ = 7°15'55"  
R = 200.00'  
L = 25.36'

30'

361.78'

50°20'50"W

400.00'

S89°39'10"E

715.08'

285.05'

336.74'

N02°45'00"E

345.45'

S02°45'00"W

30'e

Δ = 9°44'20"  
R = 630.00'  
L = 107.08'

S12°29'20"W

Δ = 17°07'40"  
R = 300.00'  
L = 89.68'



S4°38'20"E

105.01'

73.63'

30'o

30'

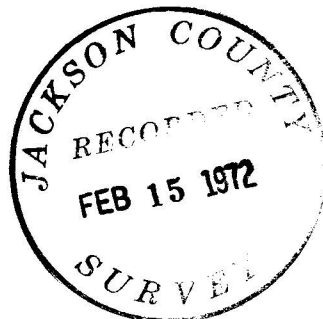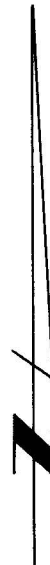

REGISTERED PROFESSIONAL LAND SURVEYOR

*Edward A. McGinty*

OREGON JULY 10, 1953 EDWARD A. MCGINTY 301

SURVEY IN W1/2 SEC 27 & E1/2 SEC 28 T 38 S R 3W WM.

FOR

EDWARD R. STUEDLE

71-42

BY EDWARD MCGINTY  
MEDFORD OREGON  
DECEMBER 1971

SCALE 1" = 100'  
○ = SET 5/8" I.PIN  
□ = SET 2" W.HUB  
● = FD 5/8" I.PIN

4786

4786

SURVEY NO. 4786

SURVEY NARRATIVE TO COMPLY WITH O.R.S. 209-250

Survey for: Edward R. Stuedle  
2256 Las Lunas  
Pasadena, Calif. 91107

Survey by: Edward A. McGinty, R.S.  
Medford, Oregon  
December, 1971

Basis of Bearing: Survey No. 3184

Location: E. 1/2 of Sec 28 and West 1/2 of Sec. 27  
T38S, R1W.

Precedence of Survey:

Surveyed tracts of land as shown and prepared descriptions for possible land transaction.

China Gulch Road was determined from monuments used on the county relocation (see county road records). These monuments being 5/8 in. pins found.

The Northerly line of Hwy. 238 is shown as approx. and determined from tangent easterly of survey and mean average tangent abutting the tracts surveyed. (Note, descriptions calls to the northerly line of Hwy. and the line shown on map is not to be construed as identical, but only approx).

Monuments set being 5/8 in. x 24 in. iron pins, set flush with the surface.

71-42

