

REGISTERED  
PROFESSIONAL  
LAND SURVEYOR

*J. G. Hoffbuhr*

OREGON  
NOV 2 1947  
J. A. HOFFBUHR  
272

JACKSON COUNTY  
RECORDED  
MAR 3 1972  
SURVEY

MAP OF SURVEY  
LOCATED IN  
N.W. 1/4 OF SECTION 16, T. 37S., R. 2 W., W.M.  
JACKSON COUNTY OREGON

FOR  
**CHARLES I. GUSTAFSON**

J. A. HOFFBUHR, REG. L.S., MEDFORD, OREGON  
SCALE: 1"=100' FEB 15, 1972  
BASIS OF BEARING - R/S NO. 2286

SURVEY NARRATIVE TO COMPLY WITH PARAGRAPH 209.250  
OREGON REVISED STATUTES

SURVEY FOR: Charles I. Gustafson  
3157 Old Stage Road  
Central Point, Oregon



LOCATION: Tract situated in the Northwest One Quarter (1/4)  
of Section 16, Township 37 South, Range 2 West,  
Willamette Meridian, Jackson County, Oregon.

PURPOSE: To establish that portion of the North line of  
Section 16 situated West of Old Stage Road.

PROCEDURE: The monuments set by Recorded Survey No. 2286, 452  
and 1650 were found and their relative locations were verified.  
The Northeast Corner of Recorded Survey No. 452 appeared to have  
been misplaced or damaged and was re-set in the position shown on  
the attached map.

Basis of bearings---Recorded Survey No. 2286.

February 29, 1972

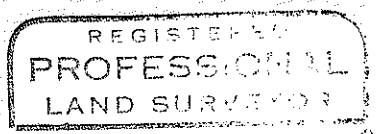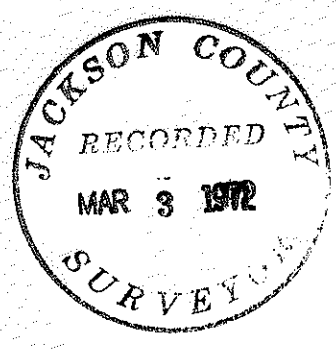

*J. A. Hoffbuhr*  
OREGON  
NOV. 7, 1947  
J. A. HOFFBUHR  
222

J. A. Hoffbuhr  
Registered Land Surveyor