-4884

SURVEY NARRATIVE TO COMPLY WITH PARAGRAPH 209.250

OREGON REVISED STATUTES

Survey for: John Carnes
723 Shasta Avenue
Eagle Point, Oregon 97524

Survey by: Charles H. Hurst
28 N. Oakdale
Medford, Oregon 97501

Bearing : Based on the meridian for Recorded Survey No. 2327

Purpose : The establishment of a proposed agreement line.

Procedure : Utilization of survey control established during the course of Recorded Survey No. 4432.

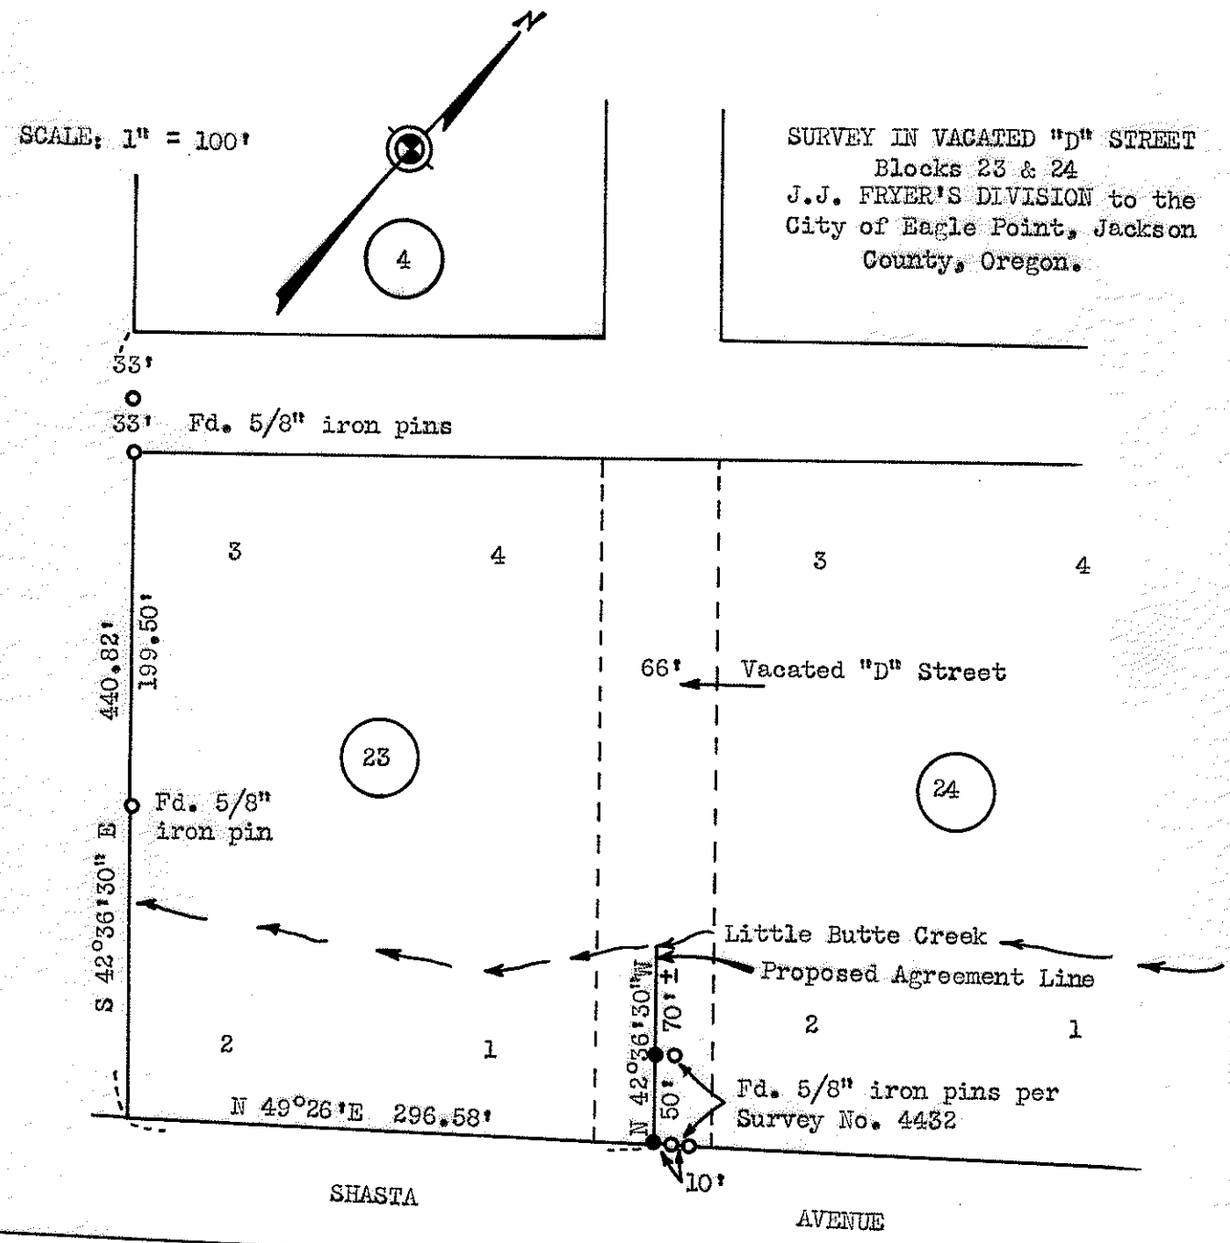

LEGEND

● Set 5/8" x 24" iron pins
○ Found 5/8" iron pins

JACKSON COUNTY
RECORDED
JUN 22 1972
SURVEYOR

REGISTERED
OREGON
LAND SURVEYOR

Charles H. Hurst

OCTOBER 30, 1959
CHARLES H. HURST
483

-4884

FEB 26 1972