-4891

SURVEY NARRATIVE TO COMPLY WITH PARAGRAPH 209.250

OREGON REVISED STATUTES

Survey for: Harvey Hunt
2110 Stewart Ave.
Medford, Oregon

Survey by: Charles H. Hurst
23 North Ivy
Medford, Oregon

Bearing : Based on the meridian for Recorded Survey No. 1427.

Purpose : Separation of the tract shown.

Procedure : Determination of the south boundary of D.R. 418-144 at record distance South from the NE corner of DLC. 77 as closing line for the tract shown. Distance by Geodimeter.

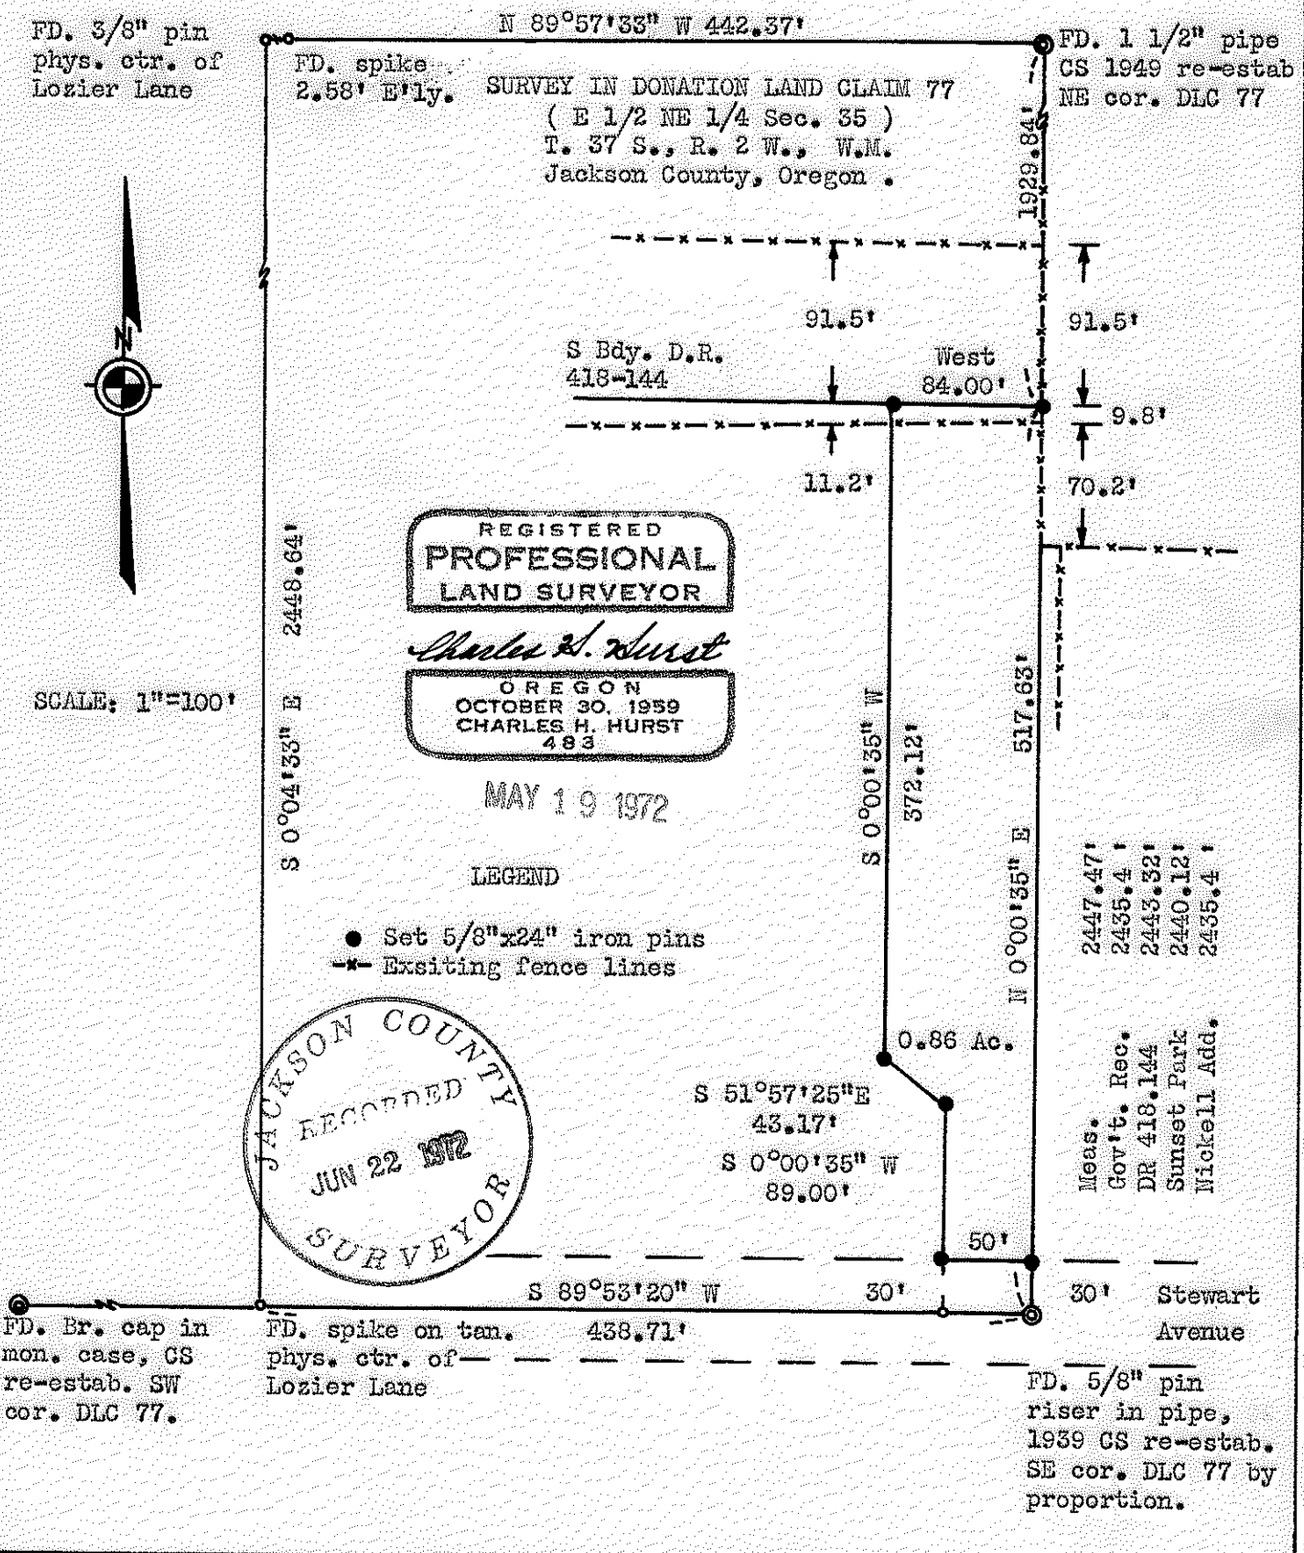

-4891