


4903

PROPERTY SURVEY
SITUATE IN
DEKUM'S AMENDED ADDITION
TO
GOLD HILL OREGON

IN THE
SE 1/4 SEC 16 T 36 S R 3 W WM
JACKSON COUNTY OREGON
G W PLUMB LAND SURVEYOR MEDFORD OREGON
SCALE 1" = 100'
1 JULY 1972

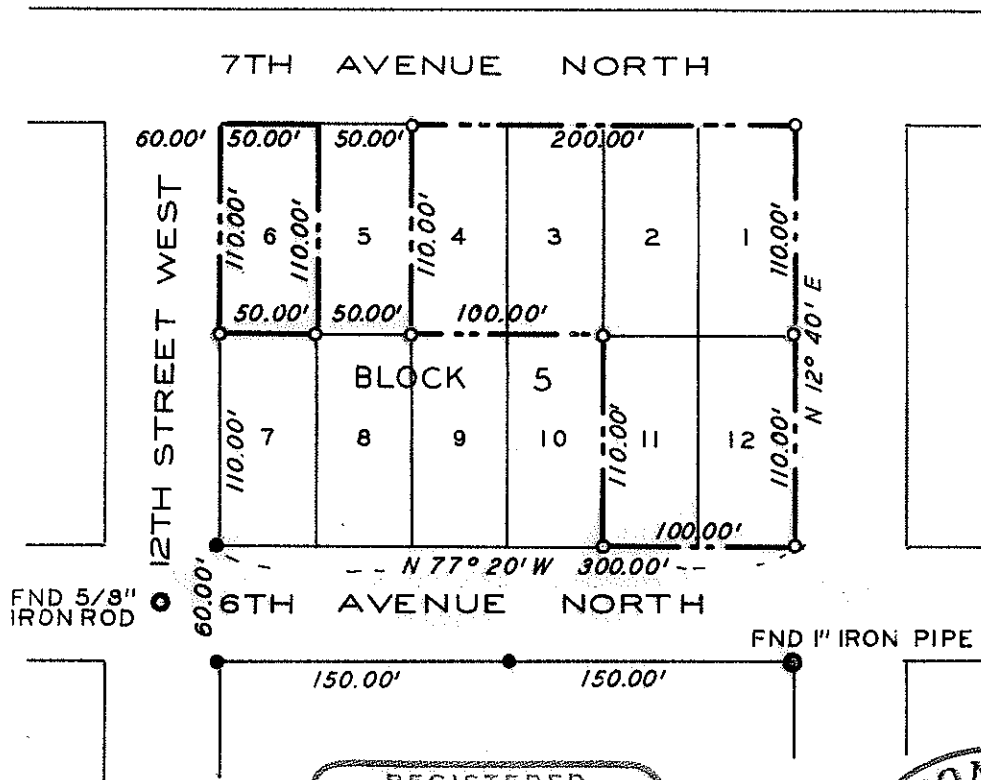

- FOUND 3/4" IRON PIPE
- SET 5/8" X 24" IRON ROD



BEARINGS FROM ORIGINAL PLAT

REGISTERED
PROFESSIONAL
LAND SURVEYOR

G. W. Plumb

OREGON
JULY 12, 1968
G. W. PLUMB
862

JACKSON COUNTY
RECORDED
JUL 17 1972
SURVEYOR

4903

Survey for James C. Downey
 319 First Avenue
 Gold Hill, Oregon 97525 Lot 6

Richard Feltersack
 5795 Sardine Creek Road
 Gold Hill, Oregon 97525 Lots 1,2,3,4,11 & 12

Survey by G. W. Plumb
 Land Surveyor
 P. O. Box 904
 Medford, Oregon 97501

Location Block 5, Dekum's Amended Addition to Gold Hill Oregon
 in the SE. $\frac{1}{4}$, Section 16, T. 36 S., R. 3 W., W.M.
 Jackson County, Oregon

Found $\frac{3}{4}$ " iron pipes at the SW. corner of Block 5; the NW. corner of Block 14, the North corner of Lots 3 & 4, Block 14; 1" iron pipe at the NE. corner of Block 14; $\frac{5}{8}$ " iron rod at the intersection of 12th Street West and 6th Avenue North. Set $\frac{5}{8}$ " x 24" iron rods at the lot corners shown on the accompanying map at the record distances and bearings shown on the original plat.

