

4934

**SURVEY FOR
UNITED TELEPHONE COMPANY
OF THE NORTHWEST**

LOCATED IN THE SW 1/4,
SEC. 29, T. 32 S. R. 3 E., W.M.
BY: MARK E. BOYDEN
AUG. 16, 1972




SCALE 1"=20'

BASIS OF BEARINGS
RECORDED SURVEY NO. 740

- FD. MON. AS INDICATED
- SET 3/4" x 24" I. PIN FL.

S Fd. 5/8" I. pin fl.
Re. R. S. No. 3689

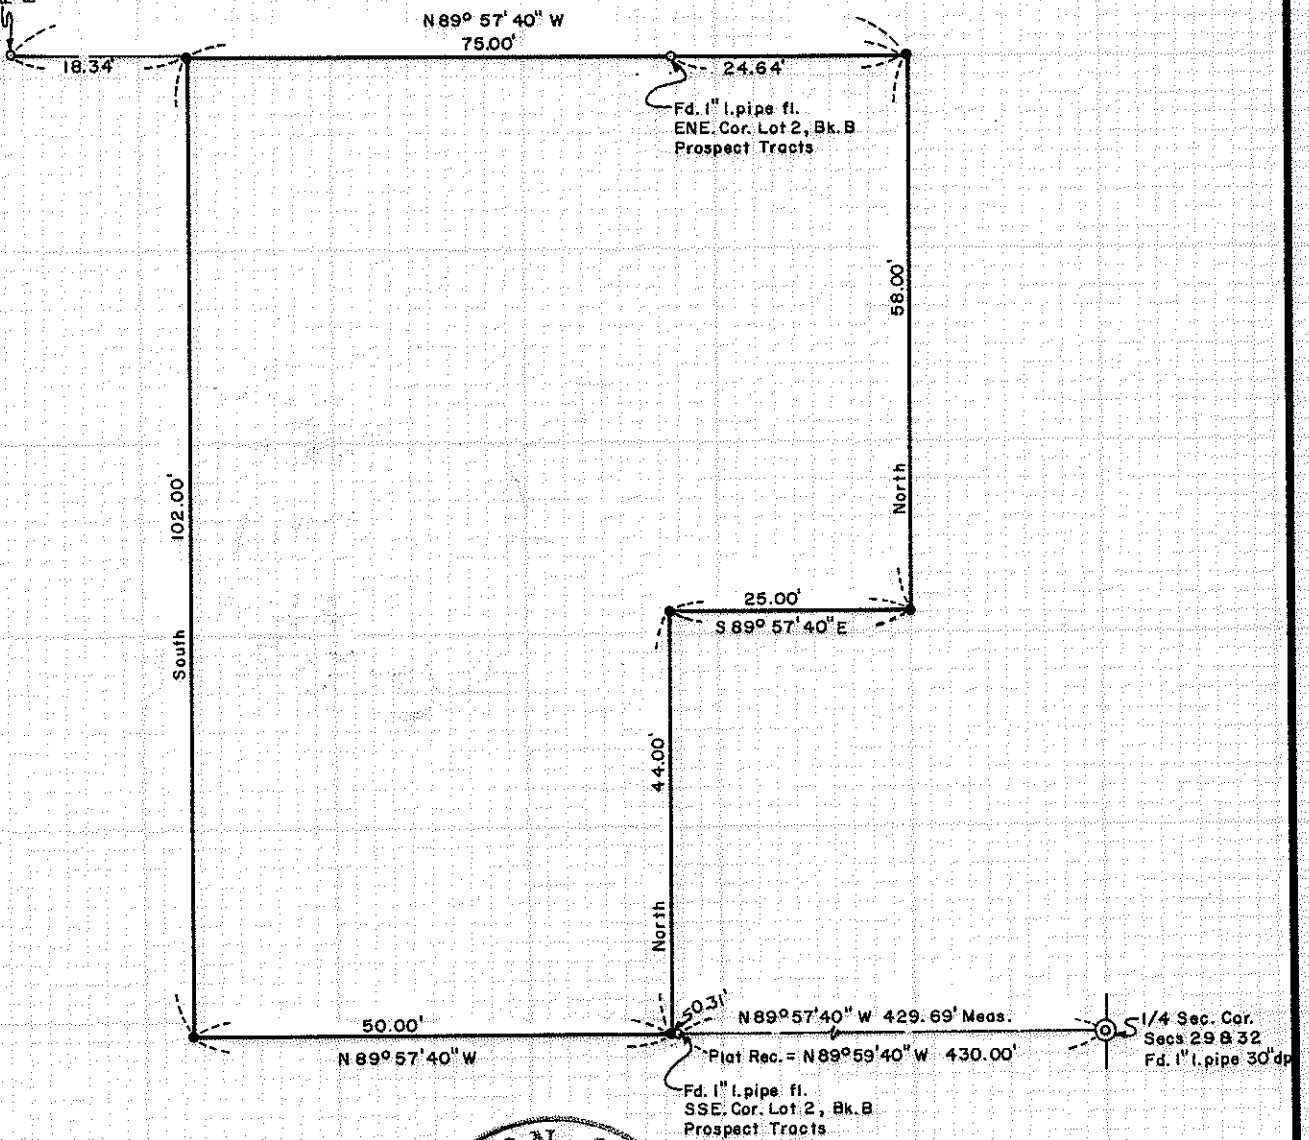

REGISTERED
PROFESSIONAL
LAND SURVEYOR

Mark E. Boyden

OREGON
NOV. 9, 1951
MARK E. BOYDEN
281

JACKSON COUNTY
RECORDED
AUG 16 1972
SURVEYOR

4934

1934
4934

SURVEY NARRATIVE TO COMPLY WITH O.R.S. 209.250

FOR: United Telephone Company of the Northwest
601 State Street
Hood River, Oregon 97031

PURPOSE: To monument the exterior corners of the Company property described in Volume 294, Page 256, Volume 568, Page 405 and in Volume 587, Page 278 of the Deed Records of Jackson County, Oregon, being located in the SW 1/4, Sec. 29, T32SR3E, W. M..

PROCEDURE: Found the 1" iron pipe for Quarter Section corner as re-established by the County Surveyor and pins set on Recorded Survey No. 740 to establish bearing control. Thence traversed to the subject property and monumented same as shown on the map to accompany this report. It should be noted that the South section boundary was established according to the plat of PROSPECT TRACTS but deed record distance West from the Quarter Section corner was utilized for distance control.

August 16, 1972

