


NOTE:
 ALL BEARINGS ARE REFERRED TO THE TRUE MERIDIAN BASE UPON SOLAR OBSERVATION.
 ——— BOUNDARY OF PROPERTY (BLAZED MARKED WITH PLASTIC RIBBON).
 - - - - - CALCULATED SUBDIVISION LINE.

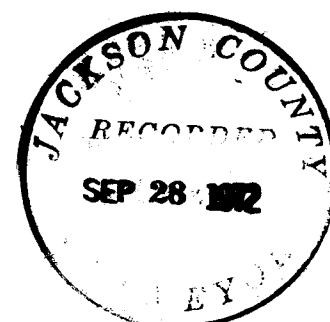

RICHARD L. TEMPLIN
 CONSULTING ENGINEER

PLAT OF DEPENDENT RESURVEY AND
 SUBDIVISION OF SECTION 34.
 T. 37 S., R. 3 E., W. M.
 JACKSON COUNTY, OREGON.

Surveyed For: Cheney Forest Products, Central Point, Oregon.
 Scale: 1" = 500'
 August 30, 1972.

(Section 34, T. 34 S., R. 3 E. Con't.)

- A White Fir, 11 ins. in diam. bears N. 27° E., 44.7 feet mkd. "C₁/S34RE3024BT"
- A Douglas Fir, 33 ins. in diam., bears N. 82° W., 59.0 feet mkd!"C₁/S34RE3024BT"
- A White Fir, 8 ins. in diam. bears S. 46° E., 50.0 ft. dist. mkd."C₁/S34RE3024BT".

Thence S. 89° 43' W. along the east and west centerline of Section 34 for 1312.0 feet to the point for the CW 1/16 section corner which I monument with a 5/8 x 30 inch iron rod with plastic cap mkd. "TEMPLIN RE3024" and from which,

- A Douglas Fir, 28 ins. in diam. bears S 60° W., 12.0 feet dist. mkd. "CW1/16S34RE3024BT".
- A White Fir, 17 ins. in diam. bears N. 40° E., 24.8 feet dist mkd. "CW1/16 S34RE3024BT."

Thence S. 00° 18' W. along the north and south centerline of the Southwest Quarter for 1324.3 feet to the point for the Southwest 1/16 Section corner which I monument with a 5/8 x 30 inch iron rod with plastic cap mkd. "TEMPLIN RE3024" and from which,

- A White Fir, 18 ins. in diam. bears S 67° E., 16.4 feet dist. mkd. "SW1/16 RE3024 BT".
- A Douglas Fir, 14 ins. in diam. bears N. 03° W., 9.0 feet distant mkd. "SW1/16 RE3024 BT"

Thence N. 89° 41 1/2' E. along the east and west centerline of the Southwest Quarter for 1319.8 feet to the point for the CS 1/16 section corner which I monument with a 5/8 x 30 inch iron rod with plastic cap mkd. "TEMPLIN RE3024" and from which,

- A Douglas Fir, 12 ins. in diam. , bears S. 10° E., 26.5 feet dist, mkd. "CS1/16 RE3024 BT"
- A Douglas Fir, 16 ins. in diam. bears S. 66° W., 24.3 feet dist. mkd. "CS1/16RE3024 BT".


Thence S. 00° 02 1/2' E. along the north and south centerline of Section 34 to the 1/4 corner common to Sections 34 and 3 herebefore described.

I then return to the CW 1/16 Section corner herebefore described and run N. 89° 47' E. along the east and west centerline of the Northeast Quarter of Section 34 for 1311.6 feet to a point for the Northeast 1/16 Section Corner which I monument with a 5/8 x 30 inch iron rod with plastic cap mkd. "TEMPLIN RE3024" and from which,

- An Incense Cedar, 20 ins. in diam. bears N. 78° E., 20.1 feet dist. mkd. "NE1/16 S34 RE3024 BT"
- A Douglas Fir, 8 ins. in diam. bears S. 12° E. , 20.9 feet dist. mkd. "NE1/16 S34 Re3024 BT ".

Thence S. 00° 10 1/2' E. along the east property line to the E 1/16 section corner common to Sections 34 and 3 herebefore described.

This survey was executed with A Wild T-16ED Transit Theodolite, A Buff and Buff on e minute transit, 200 ft steel tapes and A Hewlett Packard 3800 electronic measuring instrument. All bearings are referred to the true meridian based upon solar observations. All exterior boundary lines were blazed and marked with fluorescent orange ribbon, of the surveyed property.

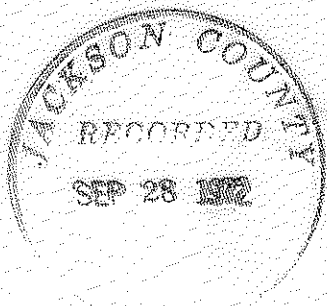

(Section 34, T. 34 S., R. 3 E. Survey Con't.)

Thence continue N. 89°41'E. on true line between Sections 34 and 3 for 1320.8 feet to the corner common to Sections 34, 35, 2 and 3 which is monumented with a 2 inch diameter wooden stake from which,

- A White Fir, 22 ins. in diam. bears N. 44° E., 69 lks dist. marks visible.
- A Douglas Fir, 20 ins. in diam., bears S. 21° E., 19 lks. dist, dead and down with plainly visible scribing.
- A Large stump hole with fir bark bears S 58° W., 45 lks. dist.

Set a 5/8th x 30 inch iron rod with plastic cap mkd. "TEPLIN RE3024" and scribed following new bearing trees as follows,

- A White Fir, 18 ins. in diam. bears N 32° E., 2.0 feet dist. mkd. "S35 RE3024 BT"
- A Douglas Fir, 12 ins. in diam., bears S. 40° E., 26.2 feet distant mkd. "S2 RE3024 BT"
- A Douglas Fir, 22 ins. in diam. bears S 70° W., 10.4 feet dist, mkd. S3 RE3024 BT"
- A Douglas Fir, 12 ins. in diam bears N. 30° W., 19.8 feet dist, mkd. "S34 RE3024 BT".

Thence N 00°18½' W. on calculated bearing for 2645.5 feet to the point for the Quarter corner common to Sections 34 and 35 which was not found after a diligent search. Inasmuch as this corner falls in the bottom of a steep and precipitous canyon and on a slide area, no corner was set.

Thence continue N 00°18½' W. on calculated bearing for 2645.5 feet to the section corner common to Sections 26, 27, 34 and 35 which is monumented with a basalt stone 24x12x6 ins. from which,

- A Douglas Fir, 46 ins. in diam., bears N 65° E., 4 lks dist. bark scribed.
- An Incense Cedar, 18 ins. in diam., bears N. 43 W., 19 lks. dist. blaze healed.
- An Incense Cedar, 12 ins. in diam. bears S. 53° W, 6 lks. dist. blaze healed.
- An Incense Cedar, 12 ins. in diam, bears S. 29° E., 18 lks. dist., marks visible.

Set 5/8th x 30 in. iron rod with plastic cap mkd. "TEMPLIN RE 3024" . Deposit stone alongside.

Thence S 89°51' W. on calculated bearing for 2617.0 feet to the Quarter corner common to Sections 27 and 34 which is monumented with a basalt stone 14 x 12 x 7 ins with ¼ mkd. on north face from which,

- A Douglas Fir, 36 ins. in diam. bears N. 42° W., 36 lks, dist. blaze Healed.
- A Douglas Fir, 24 ins. in diam. bears S 13° W. 15.4 feet dist. blaze healed.

Thence S 00°21'E on the true north and south centerline of Section 34 for 1325.7 feet to the point for the CN 1/16 section corner which I monument with a 5/8th x 30 inch iron rod with a plastic cap mkd. "TEMPLIN RE 3024" from which,

- A White Fir, 8 ins. in diam., bears N. 78° E. , 9.6 feet dist. mkd. "CN1/16 S34 RE3024 BT"
- A Douglas Fir, 14 ins. in diam. bears N. 68° W., 17.8 feet dist. mkd. "CN1/16 S34 RE3024 BT"

Thence continue S. 00°02½' E. on true north and south centerline for 1325.7 feet to the point for the center Quarter corner determined from the calculated position of the intersection of the north and south centerline with the east and west centerline and which I monument with a 5/8 x 30 inch iron rod from which,

SURVEY NARRATIVE

Location: NE $\frac{1}{4}$ of SW $\frac{1}{4}$, SW $\frac{1}{4}$ of NE $\frac{1}{4}$, W $\frac{1}{2}$ of SE $\frac{1}{4}$ of Section 34, T. 37 S., R. 3 E., Will. Mer. Jackson County, Oregon

Surveyed for: Cheney Forest Products, Central Point, Oregon

Purposes: To mark exterior boundaries for logging purposes and to monument corners of above described property

As the east half of this section is extremely precipitous and under constant land movement action, A Hewlett Packard distance measuring instrument was used to determine the position of the northeast and southeast section corners from a reference point located near the center of Section 34. A closed traverse was then made around the southeast quarter of the section and open traverse made to the north quarter corner. A description of the corners found and the calculated courses and distances to these corners is as follows:

The $\frac{1}{4}$ corner common to Sections 33 and 34 is determined from the two original bearing trees;

- A White Fir, 10 ins. in diam., bears N. 85° E., 18 lks. dist., marks visible.
- A Fir, 14 ins. in diam., bears S. 70° W., 23 lks. dist., marks visible.

At the corner point, I set a 5/8 x 30 in. iron rod with plastic cap marked "TEMPLIN RE3024" from which,

- A Douglas Fir, 26 ins. in diam. bears N. 52° E., 13.1 ft. dist. mkd. "4S33RE3024BT"
- A White Fir, 24 ins. in diam. bears N. 51° W., 18.8 ft. dist. mkd. "4S34 RE3024 BT"

Thence S. 00°38' W. on calculated bearing for 2650.0 ft. to the Section corner common to sections 33, 34, 3 and 4 which is monumented with an iron pipe, 2 $\frac{1}{2}$ ins. in diam. with brass cap mkd.

T 37 S R 3 E
 S 33 $\frac{1}{4}$ S 34
 S 4 $\frac{1}{4}$ S 3
 T 38 S
 1961

from which,

- A Fir, 16 ins. in diam bears N. 81° E., 122 lks. dist,
- A Fir, 8 ins. in diam. bears S 4° E., 150 lks. dist.
- A Fir, 10 ins. in diam. bears S. 17° W., 123 lks. dist.
- A Fir, 14 ins. in diam bears N. 47° W., 57 lks. dist.

Thence N. 89°40' E. on calculated bearing for 2665.2 feet to the $\frac{1}{4}$ corner common to Sections 34 and 3 which is determined from the following extent bearing trees,

- A Douglas Fir, 24 ins. in diam., bears S. 12° W., 34 lks. dist. blaze healed.
- A Douglas Fir, 28 ins. in diam. bears N. 53° W., 33 lks. dist. blaze healed.

At the corner point set a 5/8th x 30 in. iron rod with plastic cap mkd. "TEMPLIN"RE3024" in mound of stone.

Thence N. 89°41' E. on true line between Sections 34 and 3 for 1320.8 feet to point for E 1/16th section corner which I monument with a 5/8th x 30 inch iron rod with plastic cap mkd. "TEMPLIN RE 3024" From which,

- A White Fir, 13 ins. in diam. bears S, 80° W., 15.5 ft. dist. mkd. "E1/16 RE3024 BT"
- A White Fir, 12 ins. in diam bears N 06° W., 23.6 ft. dist. mkd. E1/16 RE3024 BT.