

4967

1/4 COR.

27 26  
34 35

N 88° 27' 47" W

N 88° 27' 47" W  
769.06'


1782.00'

S 00° 26' 47" E

S 00° 26' 47" E

835.11'

1/4 COR.

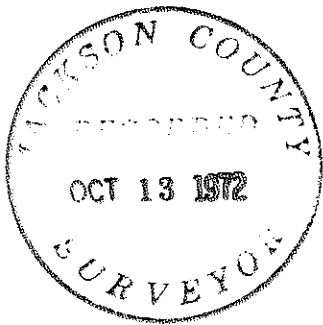

SURVEY IN NE 1/4 SEC. 34 T 38 S R 3 W WM.

FOR

LARRY CHRISTEAN AND GENE FORESEE

REGISTERED  
PROFESSIONAL  
LAND SURVEYOR

BY EDWARD MCGINTY  
MEDFORD, OREGON

SCALE 1" = 200'  
• = SET 5/8" I. PIN

*Edward A. McGinty*  
OREGON  
JULY 10 1953  
EDWARD A. MCGINTY  
301

4967

Survey No. 4967

SURVEY NARRATIVE TO COMPLY WITH O.R.S. 209-250

Survey for: Mrs. Gene Foresee  
Larry Christean 72-25  
1510 Brookdale Ave.  
Medford, Oregon

Survey by: Edward A. McGinty, R.S.  
Medford, Oregon  
June, 1972

Basis of Bearing: Survey No. 2371, line S.0°09'E., 758.24

Location: NE. 1/4 Cor. Sec. 27, T38S, R3W., WM.

Precedence of Survey:

At the corner of Secs. 26, 27, 34 & 35 found a 1 3/4 in. iron axle previously reported on survey for A. Pierce.

1/4 Cor. betw. Sec. 34 & 35, found a quartz stone, which I replace with a 5/8 in. x 24 in. iron pin

Orig. BT now a stump hole, bears N.29°E., 48.84 ft.

Orig. BT now a stump hole, bears N.64°W., 69.96 ft.


Fd. madrone, 6 ins. diam., now dead, blazed & scribed about 40 yrs. ago,  
N.83°35'E., 19.2 ft.

Fd. B. Oak, 6 ins. diam., blazed & scribed N.50°45'W., 21.0 ft.

NEW REFERENCES:

Fir, 6 ins. diam., bears N.58°E., 20.80 ft. blazed

Fir, 12 ins. diam., bears N.70°15'E., 4.00 ft. blazed

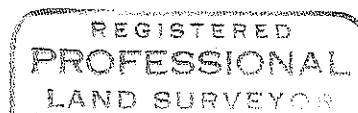

*Edward A. McGinty*  
OREGON  
JULY 10, 1953  
EDWARD A. MCGINTY  
301