


SURVEY IN SW 1/4 SEC. 3 T 35 S R 4 W W M
JACKSON CO. OREGON

SURVEY FOR
GILLEN, HOWLETT, DALLMAN, MOREY, HAAKINSON

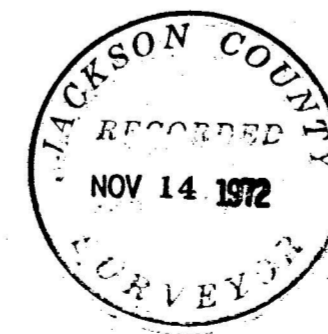

PREPARED BY
ATTIG & ZIMMERLUND CONSULTING ENGR'S
ROGUE RIVER OREGON
NOV. 1972 W.O.210

FOUND 2" IRON PIPE

FOUND 1" IRON PIPE

N 89° 46' 51" E 2656.77' (MEAS.)
2657.80' (CALC.)

SURVEY NARRATIVE TO COMPLY WITH PARA. 209.250 O.R.S.

SURVEY FOR: Gillin, Howlett, Dallman, Morey and Haakinson

PURPOSE: To survey and monument five existing parcels of land.

LOCATION: Southwest Quarter of Section 3, Township 35 South, Range 4 West of the Willamette Meridian, Jackson County, Oregon.

PROCEDURE: Found data on the west, north and east lines of said Southwest Quarter of Section 3, as shown on attached map, per R. S. #4777. Calculated south line distance to be 2,657.80 feet. Measured south line distance to be 2,656.77 feet. Used measured distance and R. S. #4777 as basis of bearings.

The original subdivision of this portion of the Southwest Quarter of Section 3 left a strip of undivided land as shown on map. All of the present owners are in agreement that they do not wish to accept additional land from apportionment of this strip of land. Front corner pins were set 20 feet easterly of the sixteenth line along the edge of an existing non-recorded road.

Set 5/8" x 24" steel pins as shown on map.

