
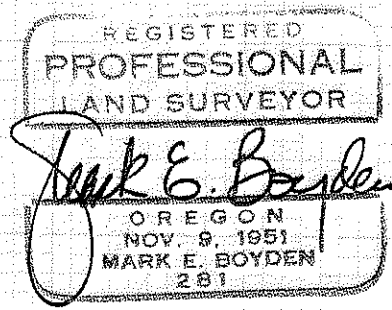


of the lower blaze;

A 14" White Oak, scribed "WC-BT" which bears N 51 1/4° W, 38.2 feet to the face of the lower blaze.

From said traverse data, monumented the tracts as shown on the map to accompany this report.

November 14, 1972

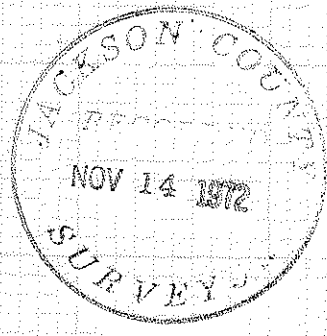

SURVEY NARRATIVE TO COMPLY WITH O.R.S. 209.250

FOR: Realestater's, Inc.
406 South Riverside Avenue
Medford, Oregon 97501

PURPOSE: To monument and describe 29 tracts being located in the East-half of the East-half of Section 2 and the Northeast Quarter of Section 11 in T35SR2W, W. M.,

PROCEDURE: Enclosed the subject tract by random traverse, tying to Government corners and other controlling monuments found as shown. At the North one-sixteenth Section corner common to Sections 1 and 2, set a 3/4" X 36" galvanized iron pipe with a 2" bronze cap stamped:

T35SR2W

N 1/16 2 + 1
Cor.

RS 281 , 33" in the ground for corner,

from which:

A 6" White Oak, scribed "N 1/16 S2-BT" bears N87 3/4°W, 24.6 feet to the face of the lower blaze;

A 7" White Oak, scribed "N1/16 S1-BT" bears S1 3/4°E, 30.7 feet to the face of the lower blaze.

At the East one-sixteenth corner common to Section 35, T34SR2W and Section 2, T35SR2W, set a witness corner, S89° 58' 20" W, 54.91 feet from the true corner position, said witness corner being a 3/4" X 36" galvanized iron pipe with a 3" bronze cap stamped:

T 34 - 35 S R 2 W

Wit. Cor.

S 89° 58' 20" W 54.91'

From . E 1/16

S. 35

S. 2

RS 281 , 33" in the ground for witness

corner, from which:

A 15" White Oak, scribed "WC-BT" bears S 48 1/2° W, 107.0 feet to the face