

4986

SECTION CORNER  
FOUND 6" X 6" CONC. MONUMENT  
WITH BRASS CAP

14 13  
23 24  
SOUTH  
424.10'

EAST 2037.43'

SOUTHERN PACIFIC RAILROAD

S18°28'15"E 25.28'  
N79°45'36"E 656.68'

TABLE ROCK ROAD



S79°45'18"W 50.52'  
S19°25'15"E

750.00'

S83°35'  
S 25°28'15"W

S 71° 34' 45" W

650.00'

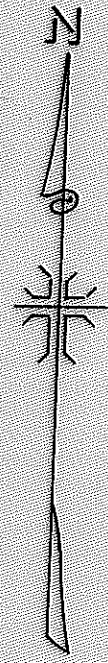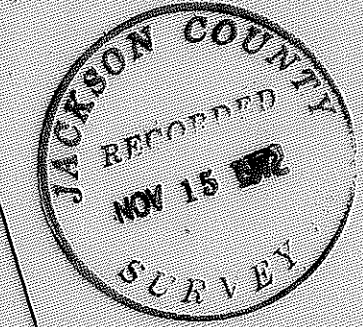

MAP OF SURVEY  
LOCATED IN  
N.W. 1/4 SECTION 24, T.36S., R. 2 W., W.M.  
JACKSON COUNTY OREGON  
FOR  
WHITE CITY CORPORATION

J. A. HOFFBUHR, REG. L. S., MEDFORD, OREGON  
SCALE: 1" = 200'  
BASIS OF BEARING SOLAR OBSERVATION  
OCT. 23, 1972  
= SET 5/8" X 24" IRON REINFORCING PIN

REGISTERED  
PROFESSIONAL  
LAND SURVEYOR

*J. A. Hoffbuhr*

OREGON  
NOV. 7, 1947  
J. A. HOFFBUHR  
222

4986

SURVEY NARRATIVE TO COMPLY WITH PARAGRAPH 209.250  
OREGON REVISED STATUTES

SURVEY FOR: White City Corporation  
White City, Oregon

LOCATION: Tract situated in the Northwest One Quarter (1/4) of  
Section 24, Township 36 South, Range 2 West of the  
Willamette Meridian, Jackson County, Oregon.

PURPOSE: To monument the corners and describe the tract of  
land as delineated on the attached map.



PROCEDURE: The center line controls established by the Jackson  
County Engineer for the centerline of the County Road (Table Rock Road)  
in conjunction with the monuments, found and indicated on the map.

The center of the railroad right of way was determined from the  
existing center line of the mean alinement of the rails. The recorded  
width of right of way being 50.00 feet total was used for the railroad  
right of way. The Southerly and Westerly lines were located by dis-  
tances determined by the client.

The controls established for Recorded Survey No. 3714 was used  
for this survey. Basis of bearings - Solar Observation.

November 13, 1972

J. A. Hoffbuhr  
Registered Land Surveyor

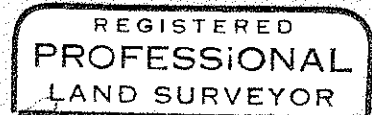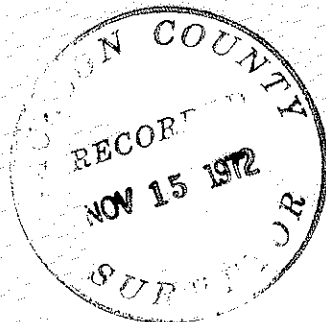

*J. A. Hoffbuhr*

