

5002

SURVEY FOR DAVID MCCLOY

SEC. 31, T. 36 S., R. 1 W., W.M.
JACKSON COUNTY, OREGON



May 10, 1972

SURVEY 2506

TRACT 34

LEGEND

- 5/8" x 24" Iron Pin set
- Monument found per Recorded Surveys

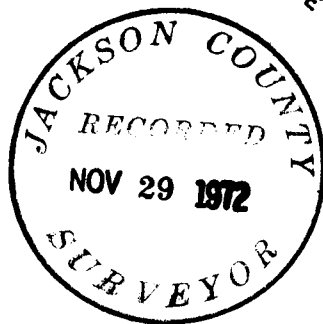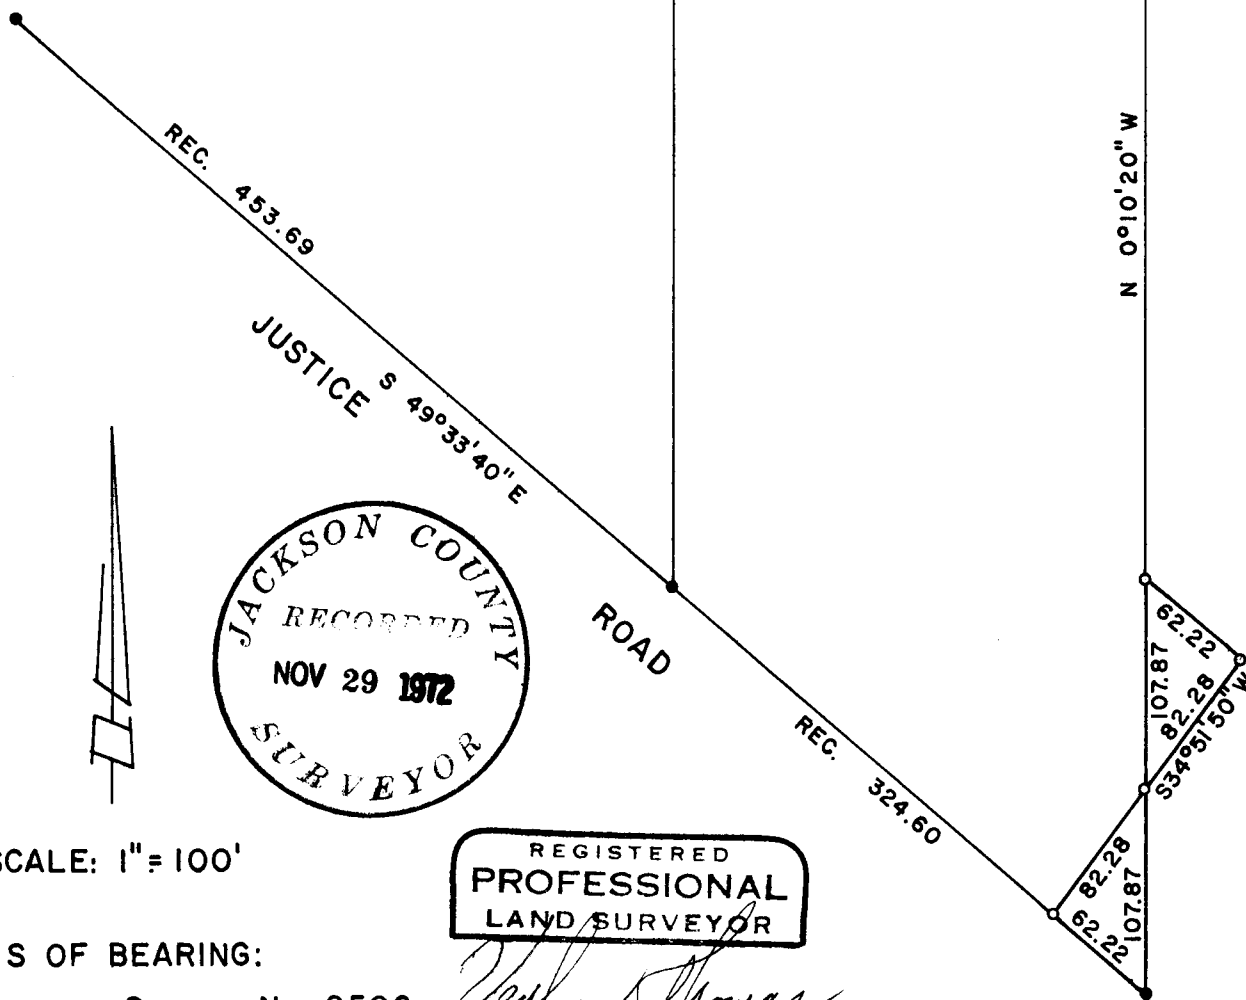

SCALE: 1" = 100'

BASIS OF BEARING:

Survey No. 2506

REGISTERED
PROFESSIONAL
LAND SURVEYOR

Verlyn Thomas
OREGON
MAY 13, 1980
VERLYN D. THOMAS
305

Survey No. 5002

SURVEY NARRATIVE TO COMPLY WITH O.R.S. 209.250
REVISED BY CHAPTER 555, O.L. 1963

FOR: David McCloy
P.O. Box 455
Jacksonville, Oregon

PURPOSE: To survey and monument two small parcels of equal area for an exchange, and prepare legal descriptions.

PROCEDURE: Recovered monuments as established in Recorded Survey No. 2506, and monumented exchange areas as indicated on the accompanying Plat.

