

5016

SURVEY NARRATIVE TO COMPLY WITH PARAGRAPH  
209.250 OREGON REVISED STATUTES

Survey for: Albert J. Boris  
4127 Colver Road  
Medford, Oregon 97501

SURVEY BY: Charles H. Hurst, L.S.  
23 North Ivy  
Medford, Oregon 97501

Basis of bearing: Recorded Survey No. 4425.

Purpose: To monument the corners of the tract shown.



Procedure: Utilization of survey control previously established.

SURVEY IN DONATION LAND CLAIM NO. 55

(NW $\frac{1}{4}$ SW $\frac{1}{4}$  Sec. 15 & NE $\frac{1}{4}$ SE $\frac{1}{4}$  Sec. 16)

T. 38 S., R. 1 W., W.M., Jackson County, Ore.

SCALE: 1" = 400'

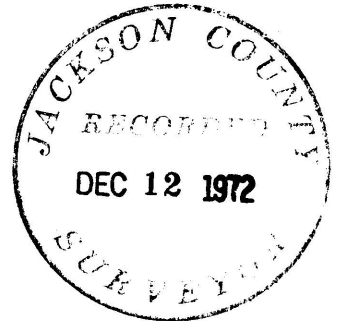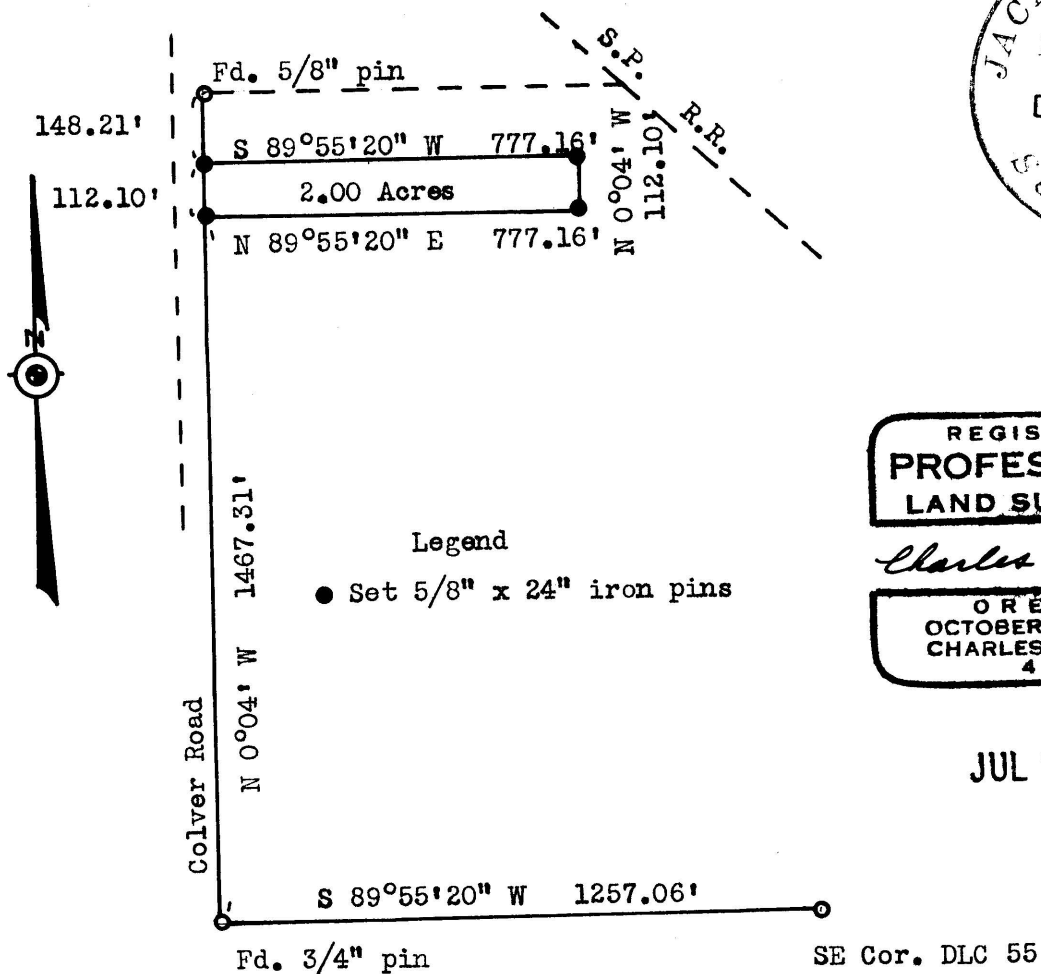

REGISTERED  
PROFESSIONAL  
LAND SURVEYOR

*Charles H. Hurst*

OREGON  
OCTOBER 30, 1959  
CHARLES H. HURST  
483

JUL 22 1972

5016