

5017

SURVEY NARRATIVE TO COMPLY WITH PARAGRAPH 209.250

OREGON REVISED STATUTES

Survey for: Ted W. Miller  
11926 Blackwell Hill Road  
Gold Hill, Oregon 97525

Survey by: Charles H. Hurst, L.S.  
23 North Ivy  
Medford, Oregon 97501


Purpose: To locate and describe the alignment of an existing roadway as shown.

SURVEY IN THE SW $\frac{1}{4}$ SW $\frac{1}{4}$  SECTION 14, &  
NW $\frac{1}{4}$ NW $\frac{1}{4}$  SECTION 23, T. 36 S., R. 3 W., W.M.,  
JACKSON COUNTY, OREGON

SCALE: 1" = 300'

LEGEND

- Set 5/8" x 24" iron pins
- x- Existing fence lines

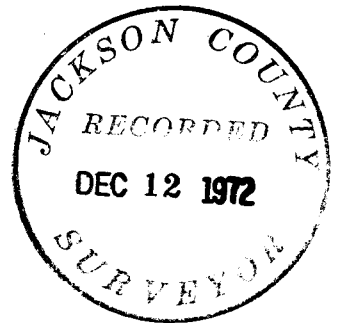

REGISTERED  
PROFESSIONAL  
LAND SURVEYOR

*Charles H. Hurst*

OREGON  
OCTOBER 30, 1959  
CHARLES H. HURST  
483

OCT 3 1972

5017

