

SURVEY NARRATIVE TO COMPLY WITH  
 PARAGRAPH 209.250, OREGON  
 REVISED STATUTES


Survey location: SE  $\frac{1}{4}$  NE  $\frac{1}{4}$  Section 19, T.37S.,  
 R. 1 W., W.M., J.C.O.

Survey for: M.E. Acker, 1206 Woodrow Lane  
 Medford, Oregon 97501


Survey by: Charles H. Hurst, L.S., 23 North Ivy  
 Medford, Oregon 97501

Purpose: To monument the tracts shown.

Procedure: Utilization of pre-existing survey  
 control.

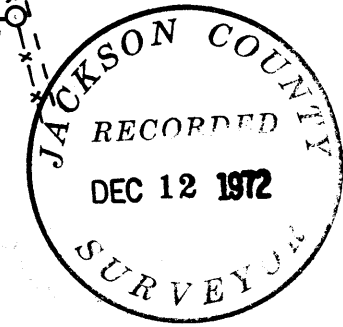

*Charles H. Hurst*

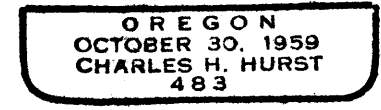

SEP 13 1972

SCALE: 1" = 100'

LEGEND

- Set 5/8" x 24" iron pins
- x- Existing fence