


5033-A

m
503

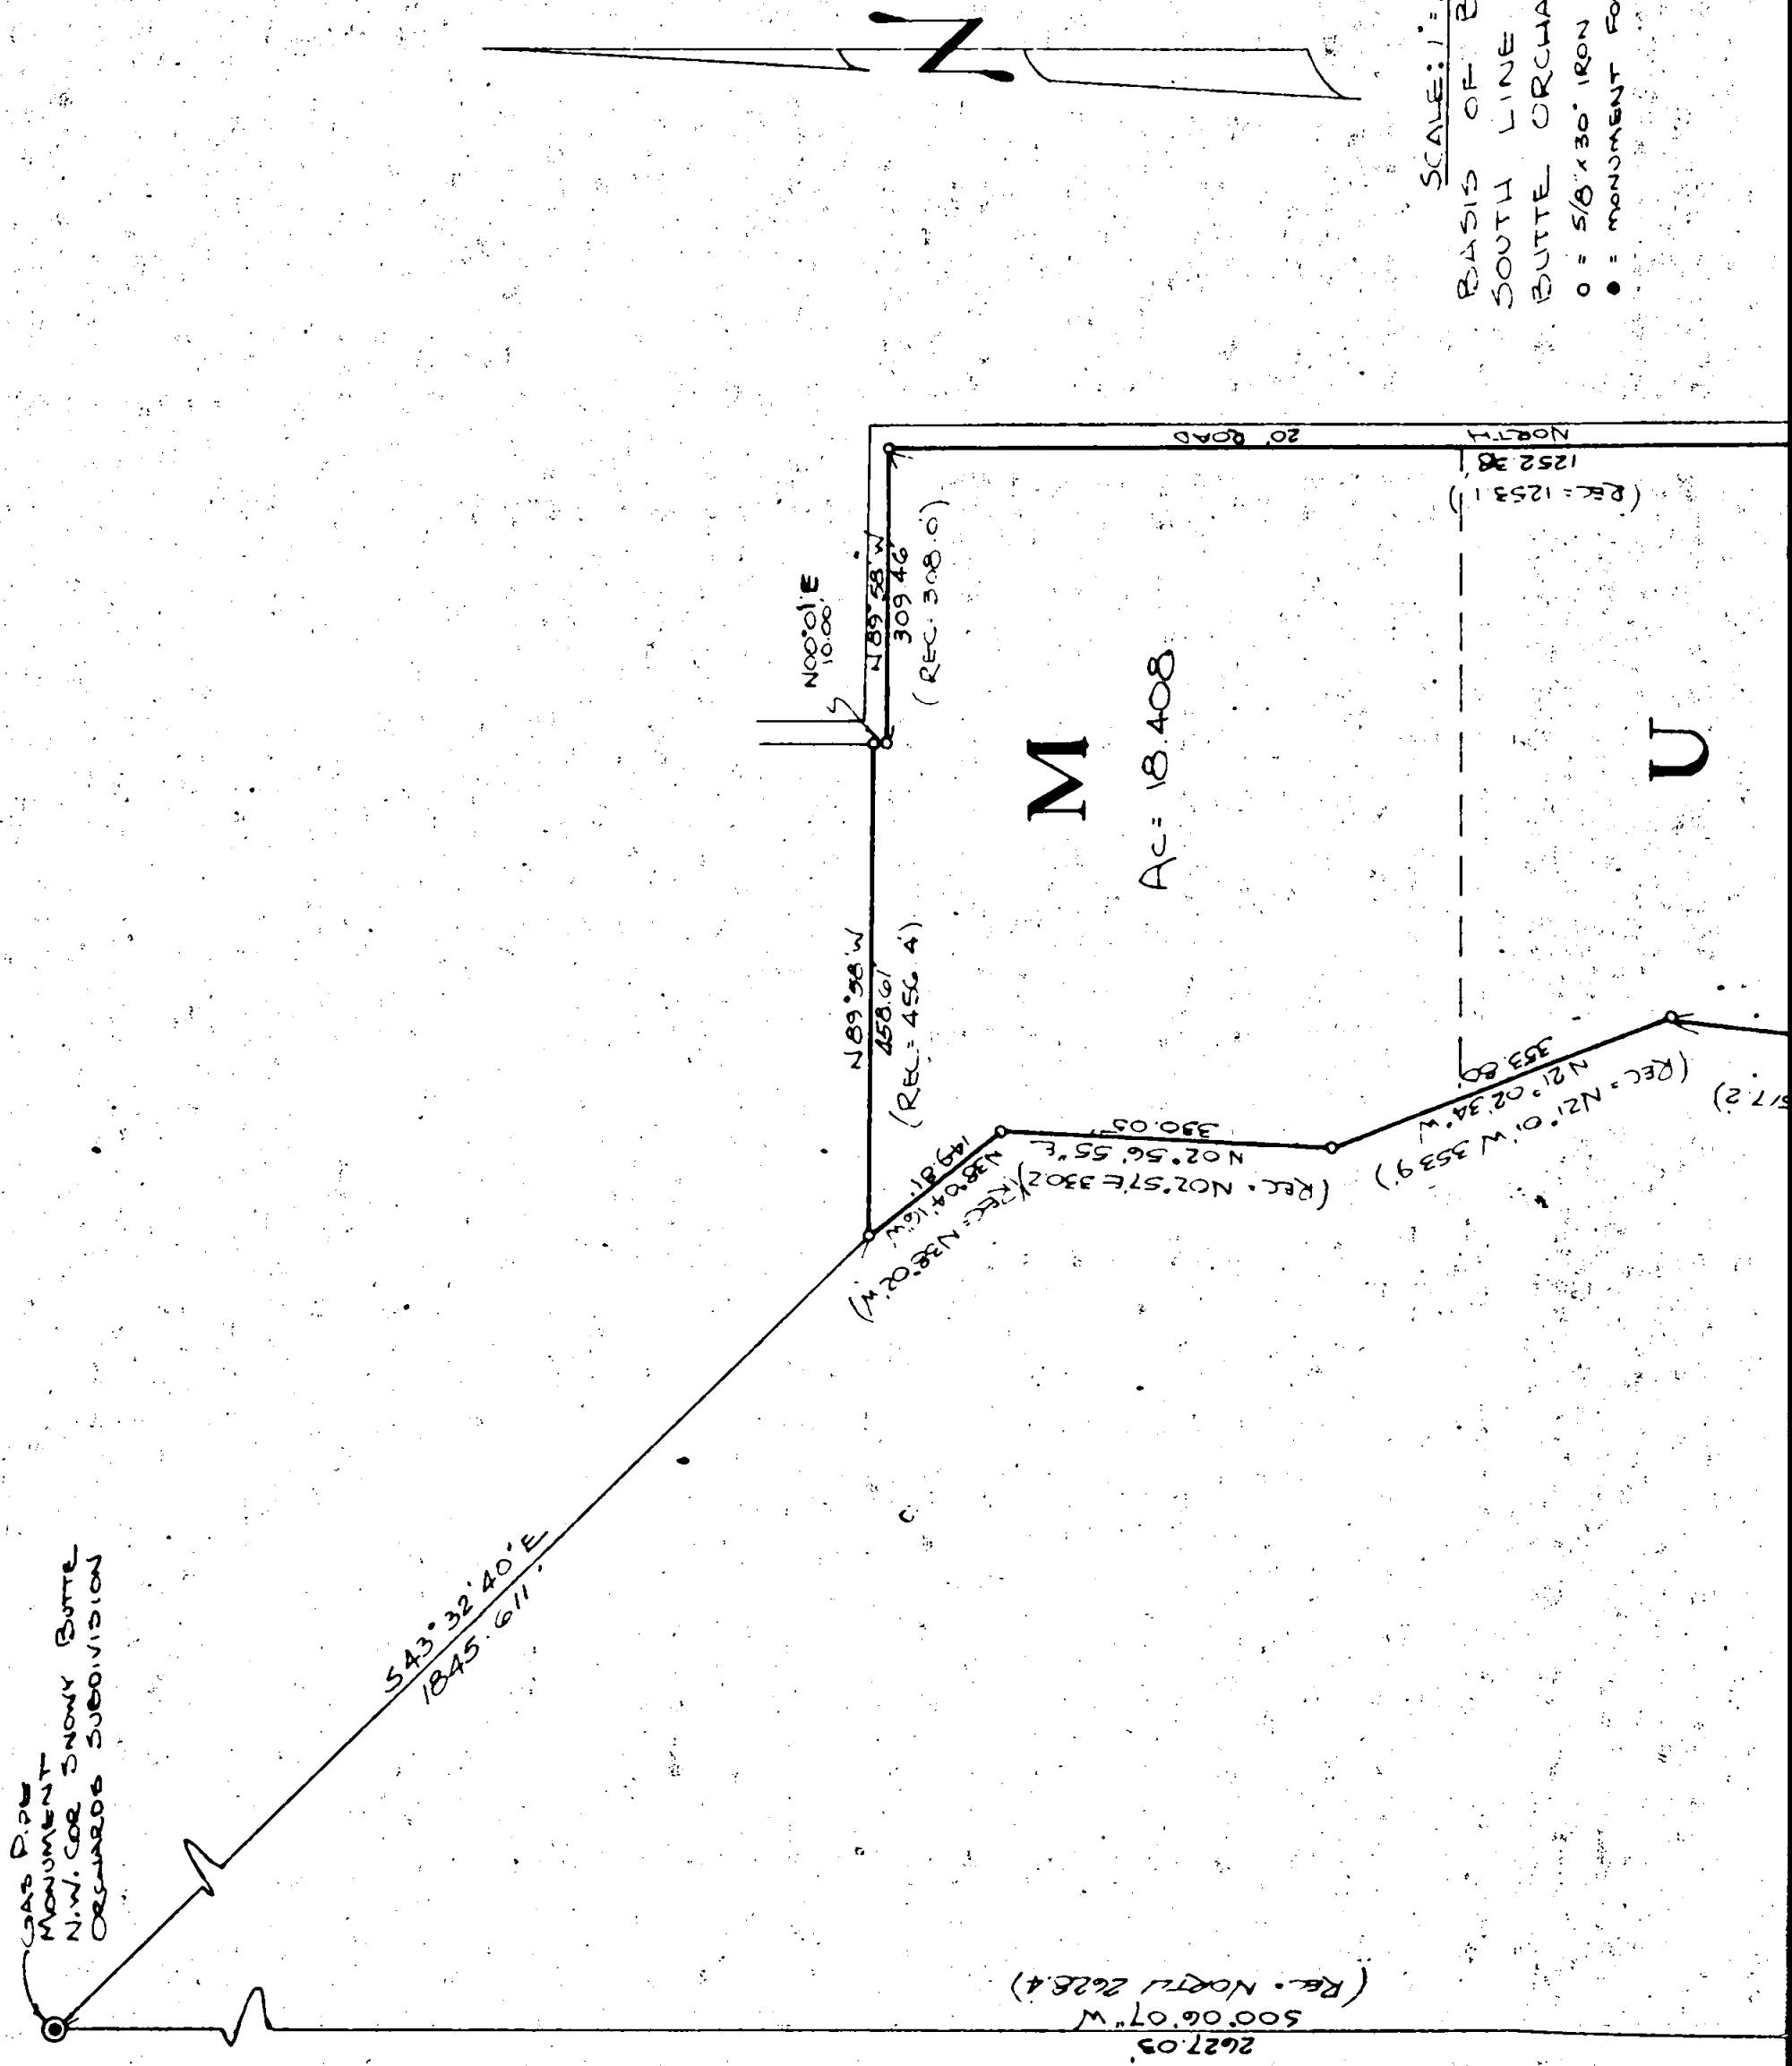

SCALE: 1 : 200
 BASIS OF BEARING:
 SOUTH LINE SNOWY
 BUTTE ORCHARDS SUES
 O = S 6° x 30' IRON ROD SET
 ● = MONUMENT FOUND

SURVEY NARRATIVE TO COMPLY WITH PARAGRAPH 209.250 O. R. S.

SURVEY FOR: Louis D. Farnsworth, Jr.
2450 Calabar Drive
Eugene, Oregon

LOCATION: Lots M & U, Snowy Butte Orchards Subdivision, Township
37 South, Range 2 West of the Willamette Meridian,
Jackson County, Oregon.

PURPOSE: To survey and monument the above described lots.


PROCEDURE: Found gas pipe monumenting the Southeast corner of
Snowy Butte Orchards Subdivision; thence I run North
 $89^{\circ}54'$ West, record bearing, 4951.30 feet, recorded
distance being 4950.00', to the Southwest corner of
said subdivision, which is monumented with a gas pipe.

Thence I run North $00^{\circ}06'07''$ East 2627.03 feet, record
bearing & distance being North 2628.4 feet, to a gas
pipe monumenting the Northwest corner of said sub-
division.

It should be noted at this point that when closing the
eastings, the adjusted survey closed with a distance
being 3.25 feet longer than the distance shown on the
original plat. A mathematical closure of Lots M & U
of said original plat was then attempted, and it was
found that the eastings did not close by 3.25 feet.

As the distance of the South line of said subdivision
checks closely with record distance, as does the South
line of Lot U, it was my opinion that the error was in
the North line of Lot M.

I then set pins on the North line of Lot M by single
proportionate measurement as shown on plat.

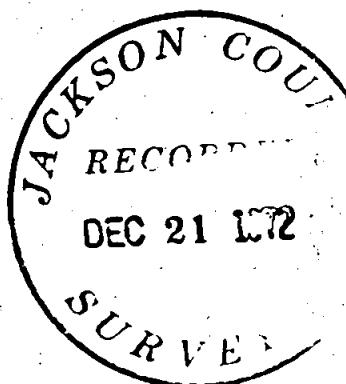

December 15, 1972

5033-B


SCALE: 1' = 200'
 BASIS OF BEARING:
 SOUTH LINE SNOWY
 BULLE ORCHARDS 200'
 0 = S/8 x 30' IRON 200 SET
 • = MONUMENT FOUND

1. 2. 


NOTE 4
1252-38
REC = 1253 1

U

$$\begin{array}{l} \text{RFE} = N 06^{\circ} 60' E \quad S 17^{\circ} 2' \\ (\text{RFE} = N 2^{\circ} 0' W \quad 35') \\ (\text{RFE} = N 2^{\circ} 0' E \quad 35') \end{array}$$

3
9
1
2
3
4

EDGAR
GAS PIPE MONUMENT
5 mi. CORNER BEND
BUTTE OREGONS
INDIVISION

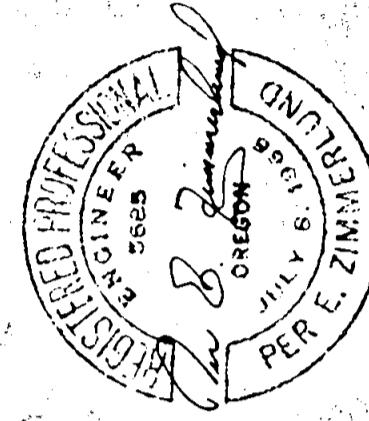

SURVEY
LOTS M & U SNOWY
BUTTE ORCHARDS SUB.,
LOCATED IN T. 37 S., R. 2 W.
W. M. JACKSON COUNTY, ORÉ

FOR FARNSWORTH JR.
LOUIS D. FARNSWORTH JR.
2480 MALABAR DRIVE, EUGENE,
OREGON

