

NORTH

REGISTERED
PROFESSIONAL
 LAND SURVEYOR

Everett L. Swain

 EVERETT L. SWAIN
 7 9

JACKSON COUNTY
 DECEMBER 29 1972
 SURVEY

MAP OF SURVEY

LOCATED IN
 LOT 2, BLK. 26 OF THE "CITY OF ASHLAND," SEC. 8, TWP 39S, R. 1E.W.M.
 JACKSON COUNTY OREGON
 FOR

J. ERWIN TONEY

EVERETT L. SWAIN, R.L.S. ASHLAND, OREGON

SCALE 1"=50'
 BASIS OF BEARING NOVEMBER 22, 1972
 RECORDED SURVEY No. 4607
 ● FOUND MONUMENTS AS SHOWN
 ○ SET 5/8 x 24 INCH IRON PIN TAGGED RLS 759

SURVEY NO. 5050

SURVEY NARRATIVE TO COMPLY WITH PARAGRAPH 209.250
OREGON REVISED STATUTES

SURVEY FOR: J. Erwin Toney
32 Black Oak Drive
Medford, Oregon 97501




LOCATION: Situated in Lot 2, Block 26 of the "City of Ashland", Section 8,
Township 39 South, Range 1 East of the Willamette Base and Meridian
Jackson County, Oregon

PURPOSE: To survey and monument the tract of land as shown on the accompanying
map, per clients request.

PROCEDURE: From previous survey control compiled on Recorded Survey No. 4807,
surveyed the tract as shown on the accompanying map.

November 22, 1972

Everett L. Swain
Professional Land Surveyor
Ashland, Oregon

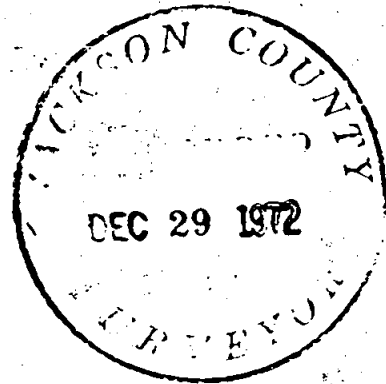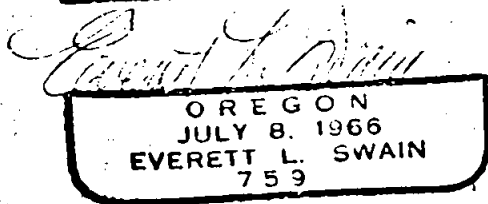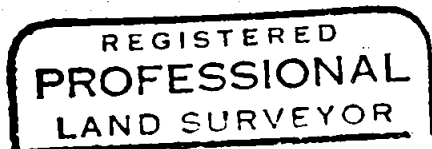

Dec 29 1972