


TERRACE STREET

HOLLY ST.

SUMMIT ST.

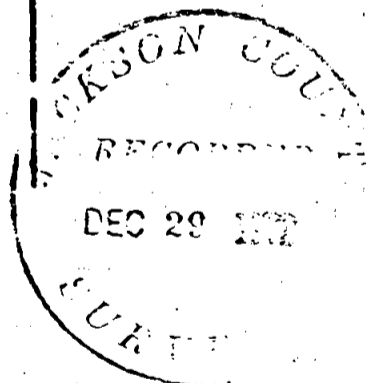

REGISTERED
PROFESSIONAL
LAND SURVEYOR

Everett L. Swain
 JULY 2, 1968
 EVERETT L. SWAIN

MAP OF SURVEY

LOCATED IN
 CARTER HEIGHTS ADDITION, UNRECORDED
 SEC. 9, TWP. 39S., R. 1E., W.B.M.
 ASHLAND, JACKSON COUNTY, OREGON
 FOR

MYRTLE A. REYNEN

EVERETT L. SWAIN, R.L.S. ASHLAND, OREGON

SCALE: 1" = 50'

AUGUST 8, 1972

BASIS OF BEARING

RECORDED SURVEY No 4026

FOUND MONUMENTS AS SHOWN

SET 5/8 INCH IRON PIN TAGGED R.L.S 759

SURVEY NO. 5051
5051

SURVEY NARRATIVE TO COMPLY WITH PARAGRAPH 209.250
OREGON REVISED STATUTES

SURVEY FOR: Myrtle A. Reynen
234 Ridge Road
Ashland, Oregon 97520

LOCATION: Situated in Carter Heights Addition, unrecorded, Section 9, Township
39 South, Range 1 East of the Willamette Base and Meridian, Jackson
County, Oregon.

PURPOSE: To survey, monument and prepare a legal description for the tract
of land as shown on the accompanying map, per clients request.

PROCEDURE: From previously established survey control, proceeded to survey and
monument the tract of land as shown on the accompanying map.

August 8, 1972

Everett L. Swain
Professional Land Surveyor
Ashland, Oregon

REGISTERED
PROFESSIONAL
LAND SURVEYOR

Everett L. Swain

OREGON
JULY 8, 1966
EVERETT L. SWAIN
759

JACKSON COUNTY
RECORDED
DEC 29 1972
SURVEYOR