

5063-A

1/4 COR., FND. WEYERHAUSER SURVKAP
ON 5/8" I. ROD, 2 REF. TREES WITH "W"
SPIKES PER JACKSON CO. SURV. FILE
NO. 4193.


SEC. COR., FND. 1" I. PIPE W/BRASS
CAP, MKD. $\frac{3}{2}$, 3 O.B.T'S., 1 O.B.T.
STUMP HOLE & SLAB, NEW B.T. PER
JACKSON CO. SURVEYORS RENEWAL, 1967.

SET 5/8" I. ROD & 2"x2"x5' STAKE
FOR TEMP. V6 COR., REF. TO YEL. B.L.M. SIGNS ON:

32" W. FIR, S 80° W 2.7 LKS.
14" W. FIR, N 25° E 41.5 LKS.

1/4 COR., FND. 1" I. PIPE/BR. CAP,
B.T'S. PER JACKSON CO. SUR-
VEYOR'S RENEWAL, 1962.

1/4 COR. FND. 1" GASPIPE
1 O.B.T., 1 O.B.T. STUMP &
RECENT B.T. PER 1938
RENEWAL BY JACKSON CO. SURVEYOR.

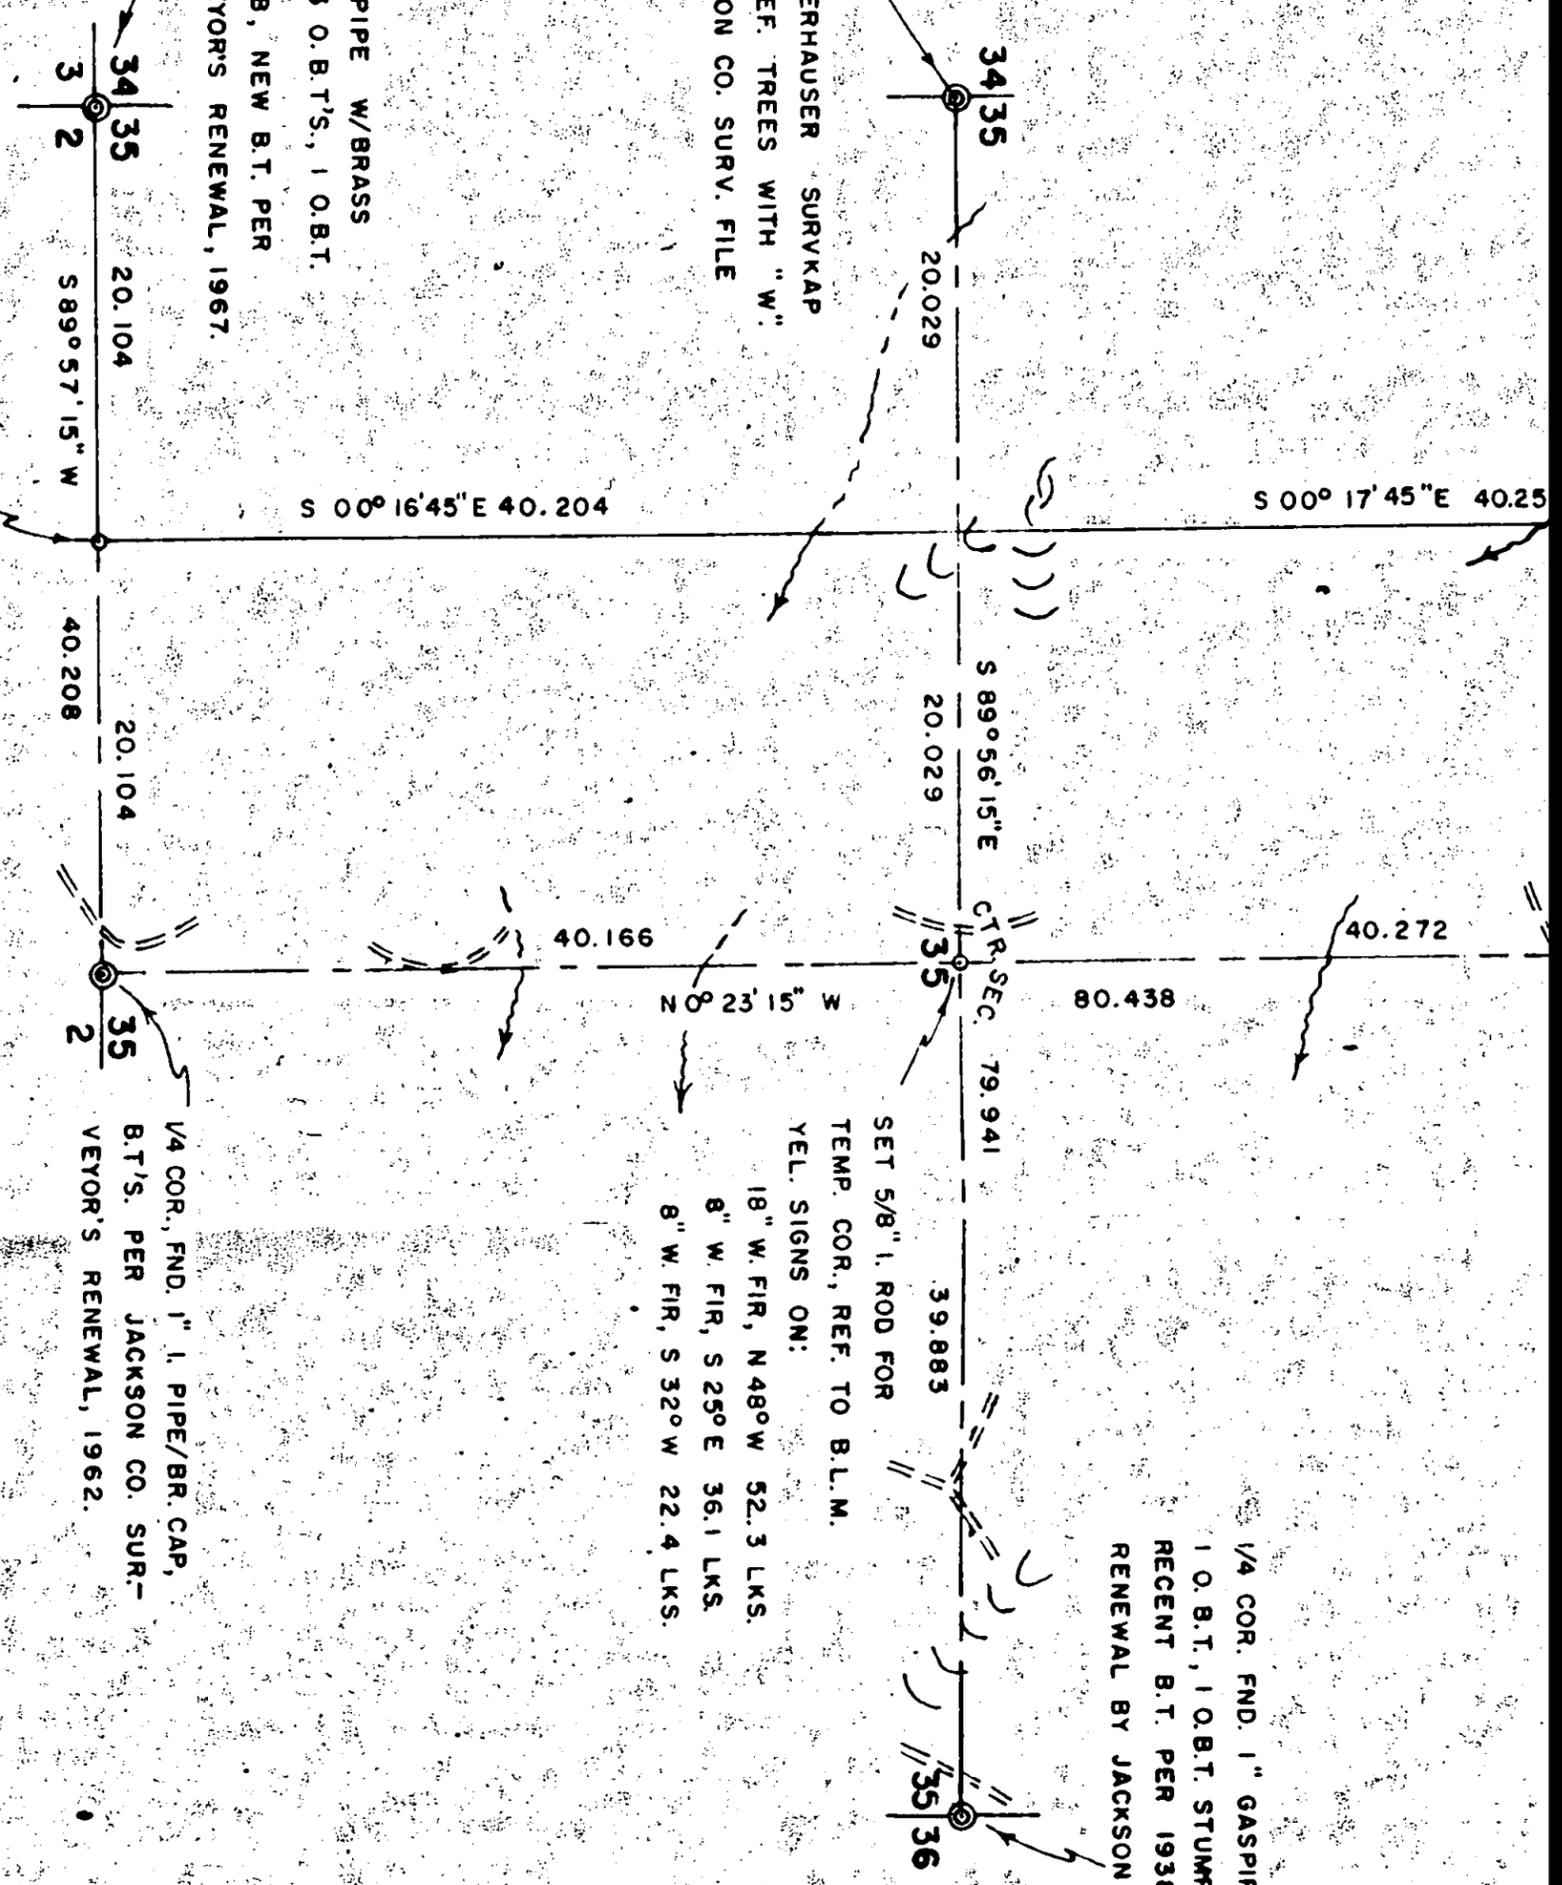

Survey of True Lines in Sections 27 & 35, T38S, R3E, W.M.
Jackson County, Oregon

Narrative description to comply with Par. 209.250, O.R.S.

for: Bureau of Land Management, Portland Service Center,
P.O. Box 3861, Portland, Oregon 97208



Purpose: To establish and mark true lines and temporary 1/16 corners, as
shown on my map, in accord with instructions from B.L.M.

Procedure:

Random East-West and North-South center lines of Section 35 were
run for control, and to determine the position of the center of the section.
The West halves of the North, and South lines of this section were also run
as random control lines. The position of the center of the section was then
determined, in order to check the position of the CW 1/16 S corner. Positions
for the W 1/16 S $\frac{26}{35}$ and W 1/16 S $\frac{35}{2}$ corners were also determined.

The East line of Section 27 was run as a random line, and the
position of the S 1/16 S 27+26 corner was determined. True lines and temporary
corners were then marked, set, and referenced, as shown on my map, for both
Sections 27 and 35.

Government corners found were verified with U.S.G.L.O. and B.L.M.
and Jackson County Surveyor's file records. Bearings were determined from
solar observations taken at the NE Corner of Section 27, and the North and
South $\frac{1}{4}$ corners of Section 35.

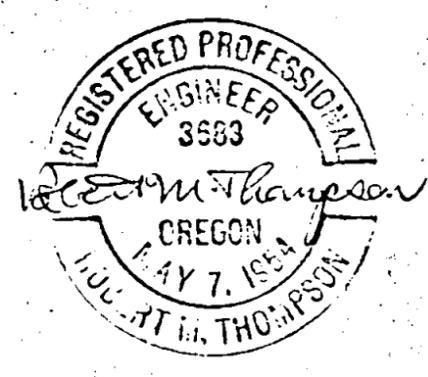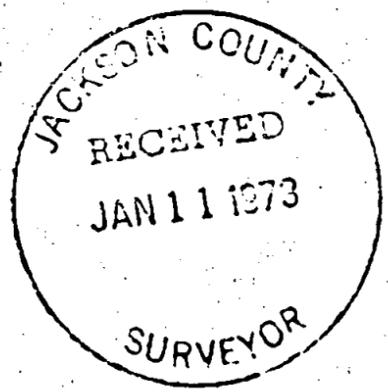

June 28, 1972

2-3-73

5063-C

5063-D

SURVEY OF TRUE LINES IN SECTIONS 27 & 35.

T. 38 S., R. 3 E., W. M., OREGON

SCALE: 1 INCH = 660 FEET



JUNE 28, 1972.


ROBT. M. THOMPSON & ASSOC.

NOTES:

THIS SURVEY & MAP WAS COMPLETED UNDER INSTRUCTIONS OF AND FOR THE EXCLUSIVE USE OF:




BUREAU OF LAND MANAGEMENT, PORTLAND SERVICE CENTER,
P.O. BOX 3861, PORTLAND, OREGON 97208.

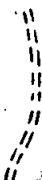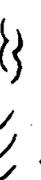-  ROAD.
-  CREEK.
-  INTERMITTENT CREEK.
-  RIDGE
-  TRUE LINE MARKED - BLUE FLAGS - ALUM. TAGS.
-  CONTROL LINE ONLY.
-  BEARINGS ROUNDED TO NEAREST 15 SEC.

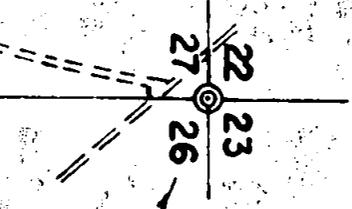

SEC. COR., FND. 2 1/2" I. PIPE W/B.L.M. BR. CAP,
DISPLACED, S 51° 33' E 1.36 LKS. FROM TRUE
COR. AS MEAS. FROM O.B.T.'S & NEW B.T.'S.
FND. PER B.L.M. 1958 RENEWAL.

TRUE BEARINGS
PER SOLAR
OBSERVATIONS

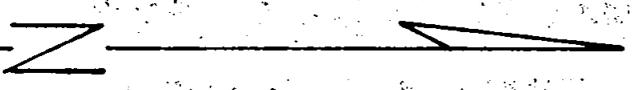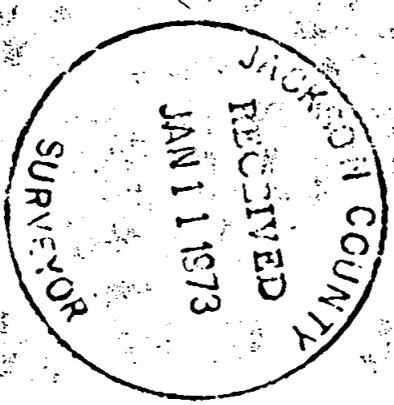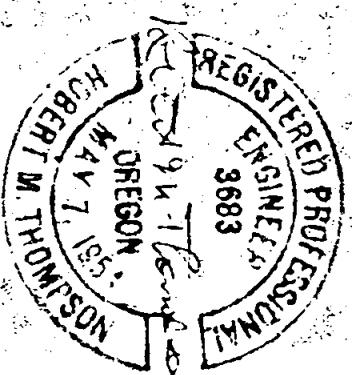

JUNE 28, 1972.

ROBT. M. THOMPSON & ASSOC.




NOTES:

THIS SURVEY & MAP WAS COMPLETED UNDER INSTRUCTIONS OF AND FOR THE EXCLUSIVE USE OF:

BUREAU OF LAND MANAGEMENT, PORTLAND SERVICE CENTER, P.O. BOX 3861, PORTLAND, OREGON 97208.


- ROAD
- CREEK
- INTERMITTENT CREEK
- RIDGE
- TRUE LINE MARKED - BLUE FLAGS - ALUM. TAGS.
- CONTROL LINE ONLY.
- BEARINGS ROUNDED TO NEAREST 15 SEC.

5063-C

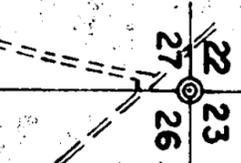

SEC. COR., FND. 2 1/2" I. PIPE W/B.L.M. BR. CAP, DISPLACED, S 51° 33' E 1.36 LKS. FROM TRUE COR. AS MEAS. FROM O.B.T.'S & NEW B.T.'S. FND. PER B.L.M. 1958 RENEWAL.

S 0° 08' 15" W 40.198

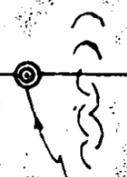


1/4 COR. FND. 2 1/2" I. PIPE W/B.L.M. BR. CAP, 1 O.B.T. & 2 NEW B.T.'S. PER 1958 B.L.M. RENEWAL.

S 0° 09' W 40.235

TEMP 1/16 COR. SET 5/8" I. ROD & 2" X 2" X 5" STAKE. REF. TO B.L.M. YEL. SIGNS ON: 34" W. FIR, N 51° W 70 LKS. 10" I. CED., S 78° E 75.3'

TEMP 1/16 COR. SET 5/8" I. ROD & 2" X 2" X 5" STAKE. REF. TO B.L.M. YEL. SIGNS ON:

TRUE BEARINGS PER SOLAR OBSERVATIONS

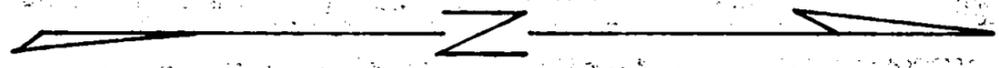

50.63-B

1/4 COR. FND. 2 1/2" I. PIPE W/B.L.M. BR. CAP,
1 O.B.T. & 2 NEW B.T.'S. PER
1958 B.L.M. RENEWAL.

TEMP 1/6 COR. SET 5/8" I. ROD & 2"x2"x5"
STAKE. REF. TO B.L.M. YEL. SIGNS ON:
34" W. FIR, N. 51° W 70 LKS.
10" I. CED, S 78° E 75.3'

TEMP 1/6 COR. SET 5/8" I. ROD & 2"x2"x5"
STAKE. REF. TO B.L.M. YEL. SIGNS ON:
16" W. FIR, S 70° W 12.1 LKS.
16" W. FIR, N 63° E 48 LKS.

SEC. COR., FND. 2 1/2" I. PIPE W/B.L.M.
BR. CAP, 4 B.T.'S. AS MARKED IN
1958 B.L.M. RENEWAL, REMAINS
OF SW & SE O.B.T.'S.

1/4 COR. FND. 1" GASPIPE
1 O.B.T., 1 O.B.T. STUMP &
RECENT B.T. PER 1938
RENEWAL BY JACKSON CO. SURVEYOR.

1/4 COR., FND. WEYERHAUSER SURV. CAP
ON 5/8" I. ROD, 2 REF. TREES WITH "W"
SPIKES PER JACKSON CO. SURV. FILE
NO. 4193

