


5066-A


Basis of Bearings Recorded Survey No. 2961

○ = Set 5/8" x 30" I Pin tagged RLS 638

● = Found monument as shown

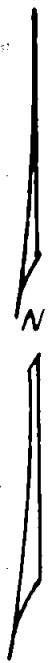

SCALE 1" = 100'

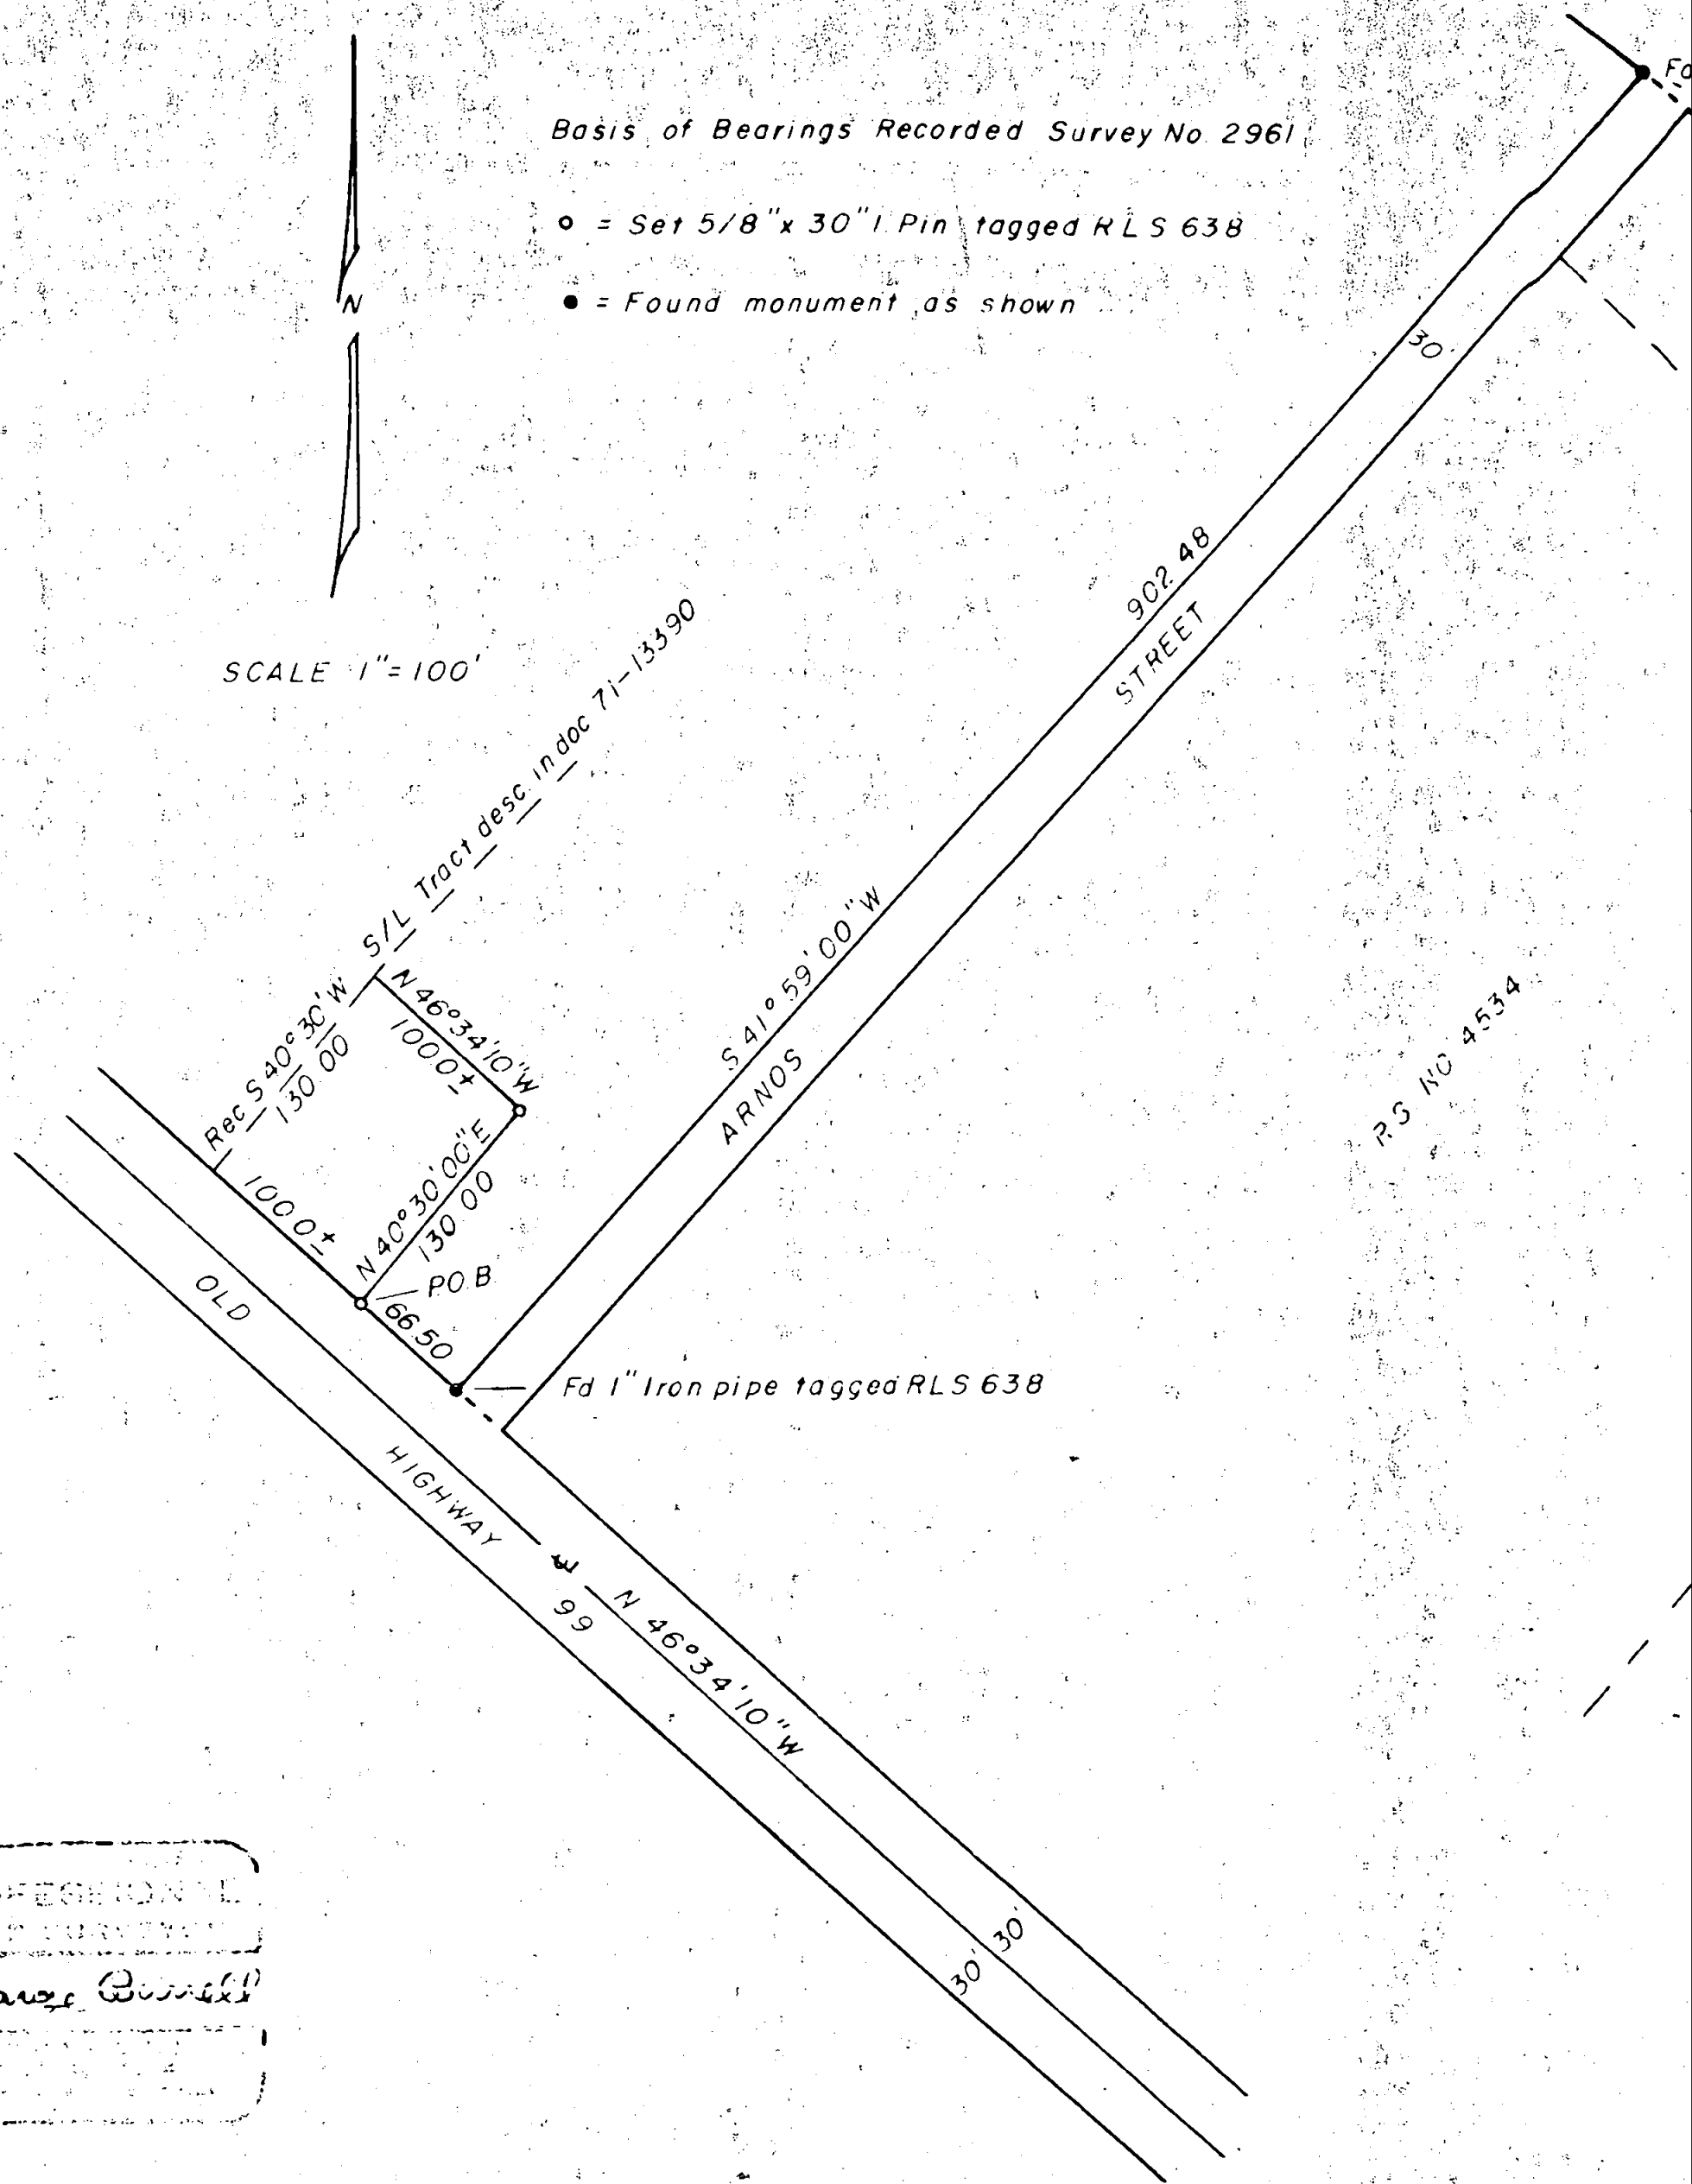

P.S. NO. 4534

PROFESSIONAL
LAND SURVEYOR

5066

SURVEY NO. 5066

SURVEY NARRATIVE TO COMPLY WITH O.R.S. 209.250

FOR: Dick Arnos
460 Arnos St.
Talent, Oregon


PURPOSE: To monument and describe the tract shown on the
accompanying map.

PROCEDURE: The monuments of Recorded Survey No. 4534 were used
as control in establishing said tract. This tract
was then monumented as shown closing on the Souther-
ly Boundary of the tract described in Document No.
71-13390 O.R., J.C., O. as this boundary was not
determined by this survey, the closing distances
were measured on a more or less basis from an exist-
ing fence apparently locating said boundary.

REGISTERED
PROFESSIONAL
LAND SURVEYOR

George Burrell

OREGON
JULY 10, 1964
GEORGE R. BURRÉLL
638

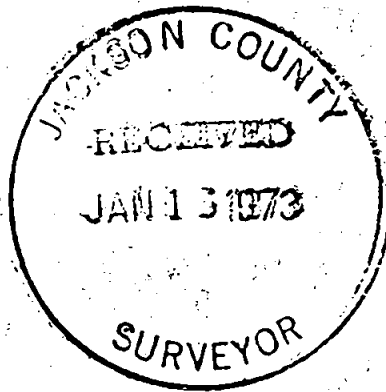


5066-B

Recorded Survey No. 2961

Pin tagged RLS 638

as shown

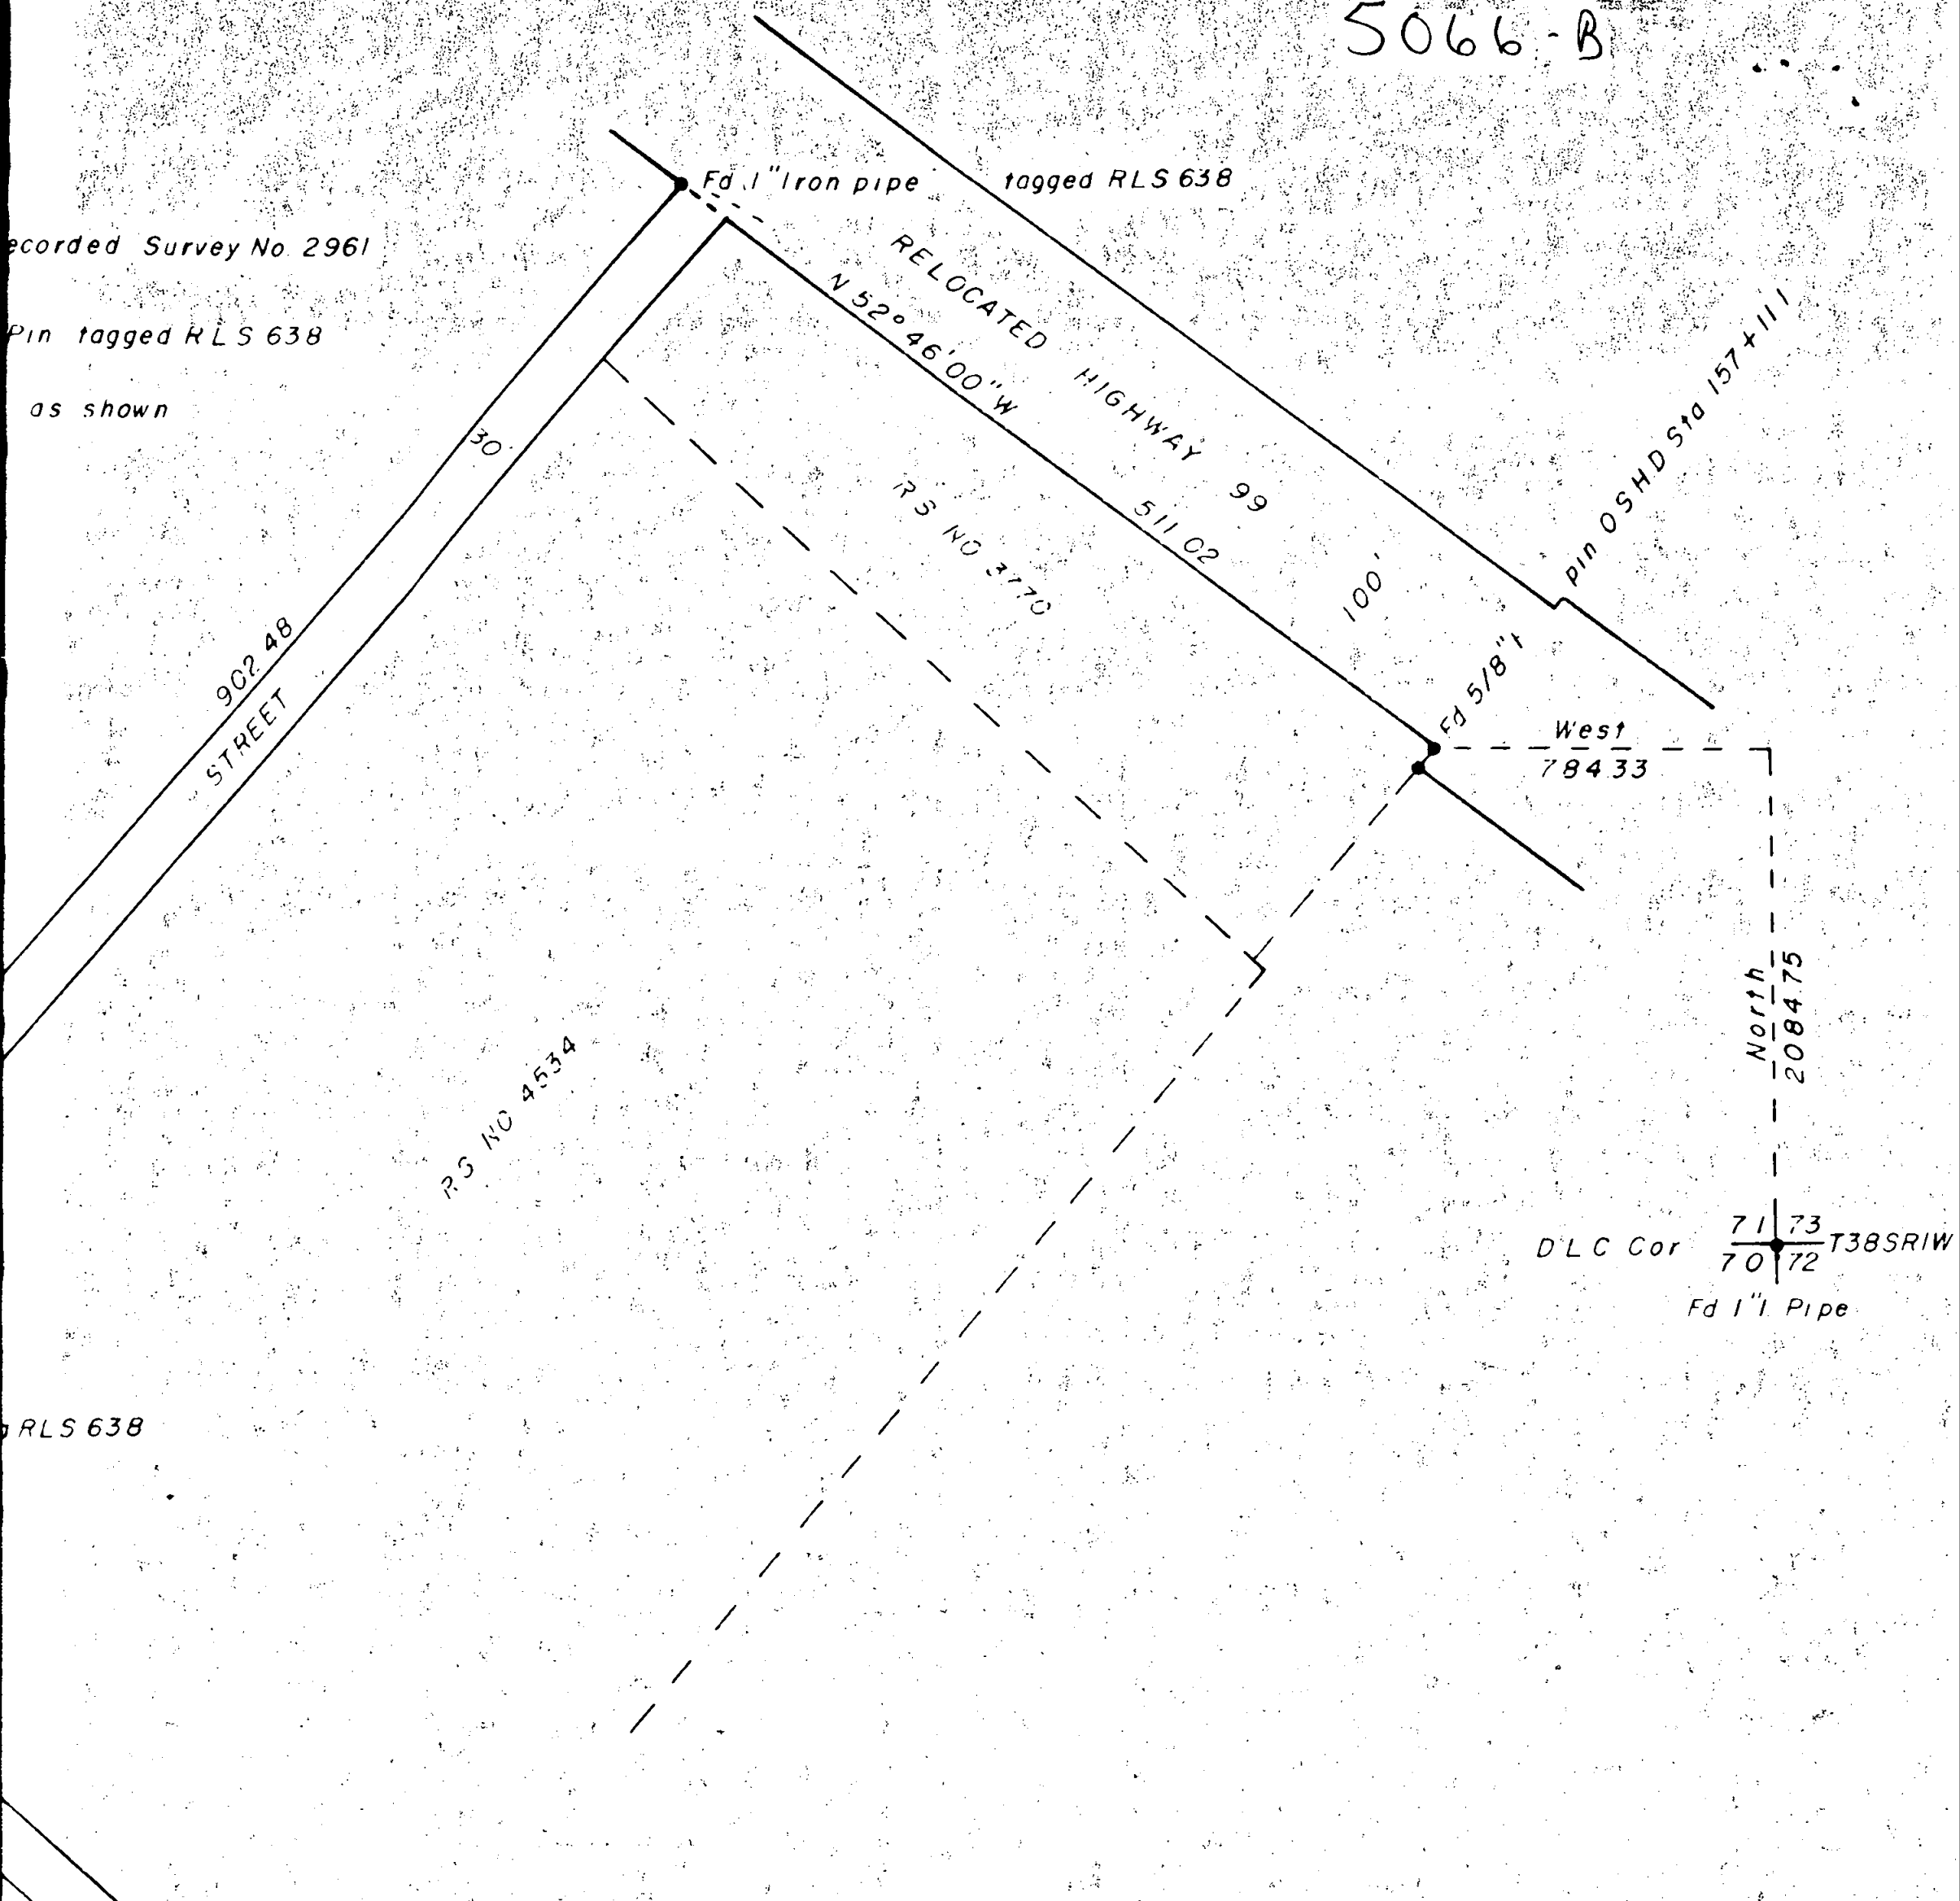

RLS 638

30' 30'

Map of Survey

Located in the NW₄ Sec 25, Twp 38S, RIW
 For: DICK ARNOS TALENT, OREGON
 By: George Burrell Surveyor Dec 1972

5066