


SURVEY FOR:

EARL COX

LOCATED IN LOT 1, BLOCK 32
OF THE ORIGINAL TOWN OF
GOLD HILL, AND IN THE NW.1/4
OF SEC. 22, T. 36S. R. 3W., W.M.

BY: MARK E. BOYDEN
FEB. 6, 1973

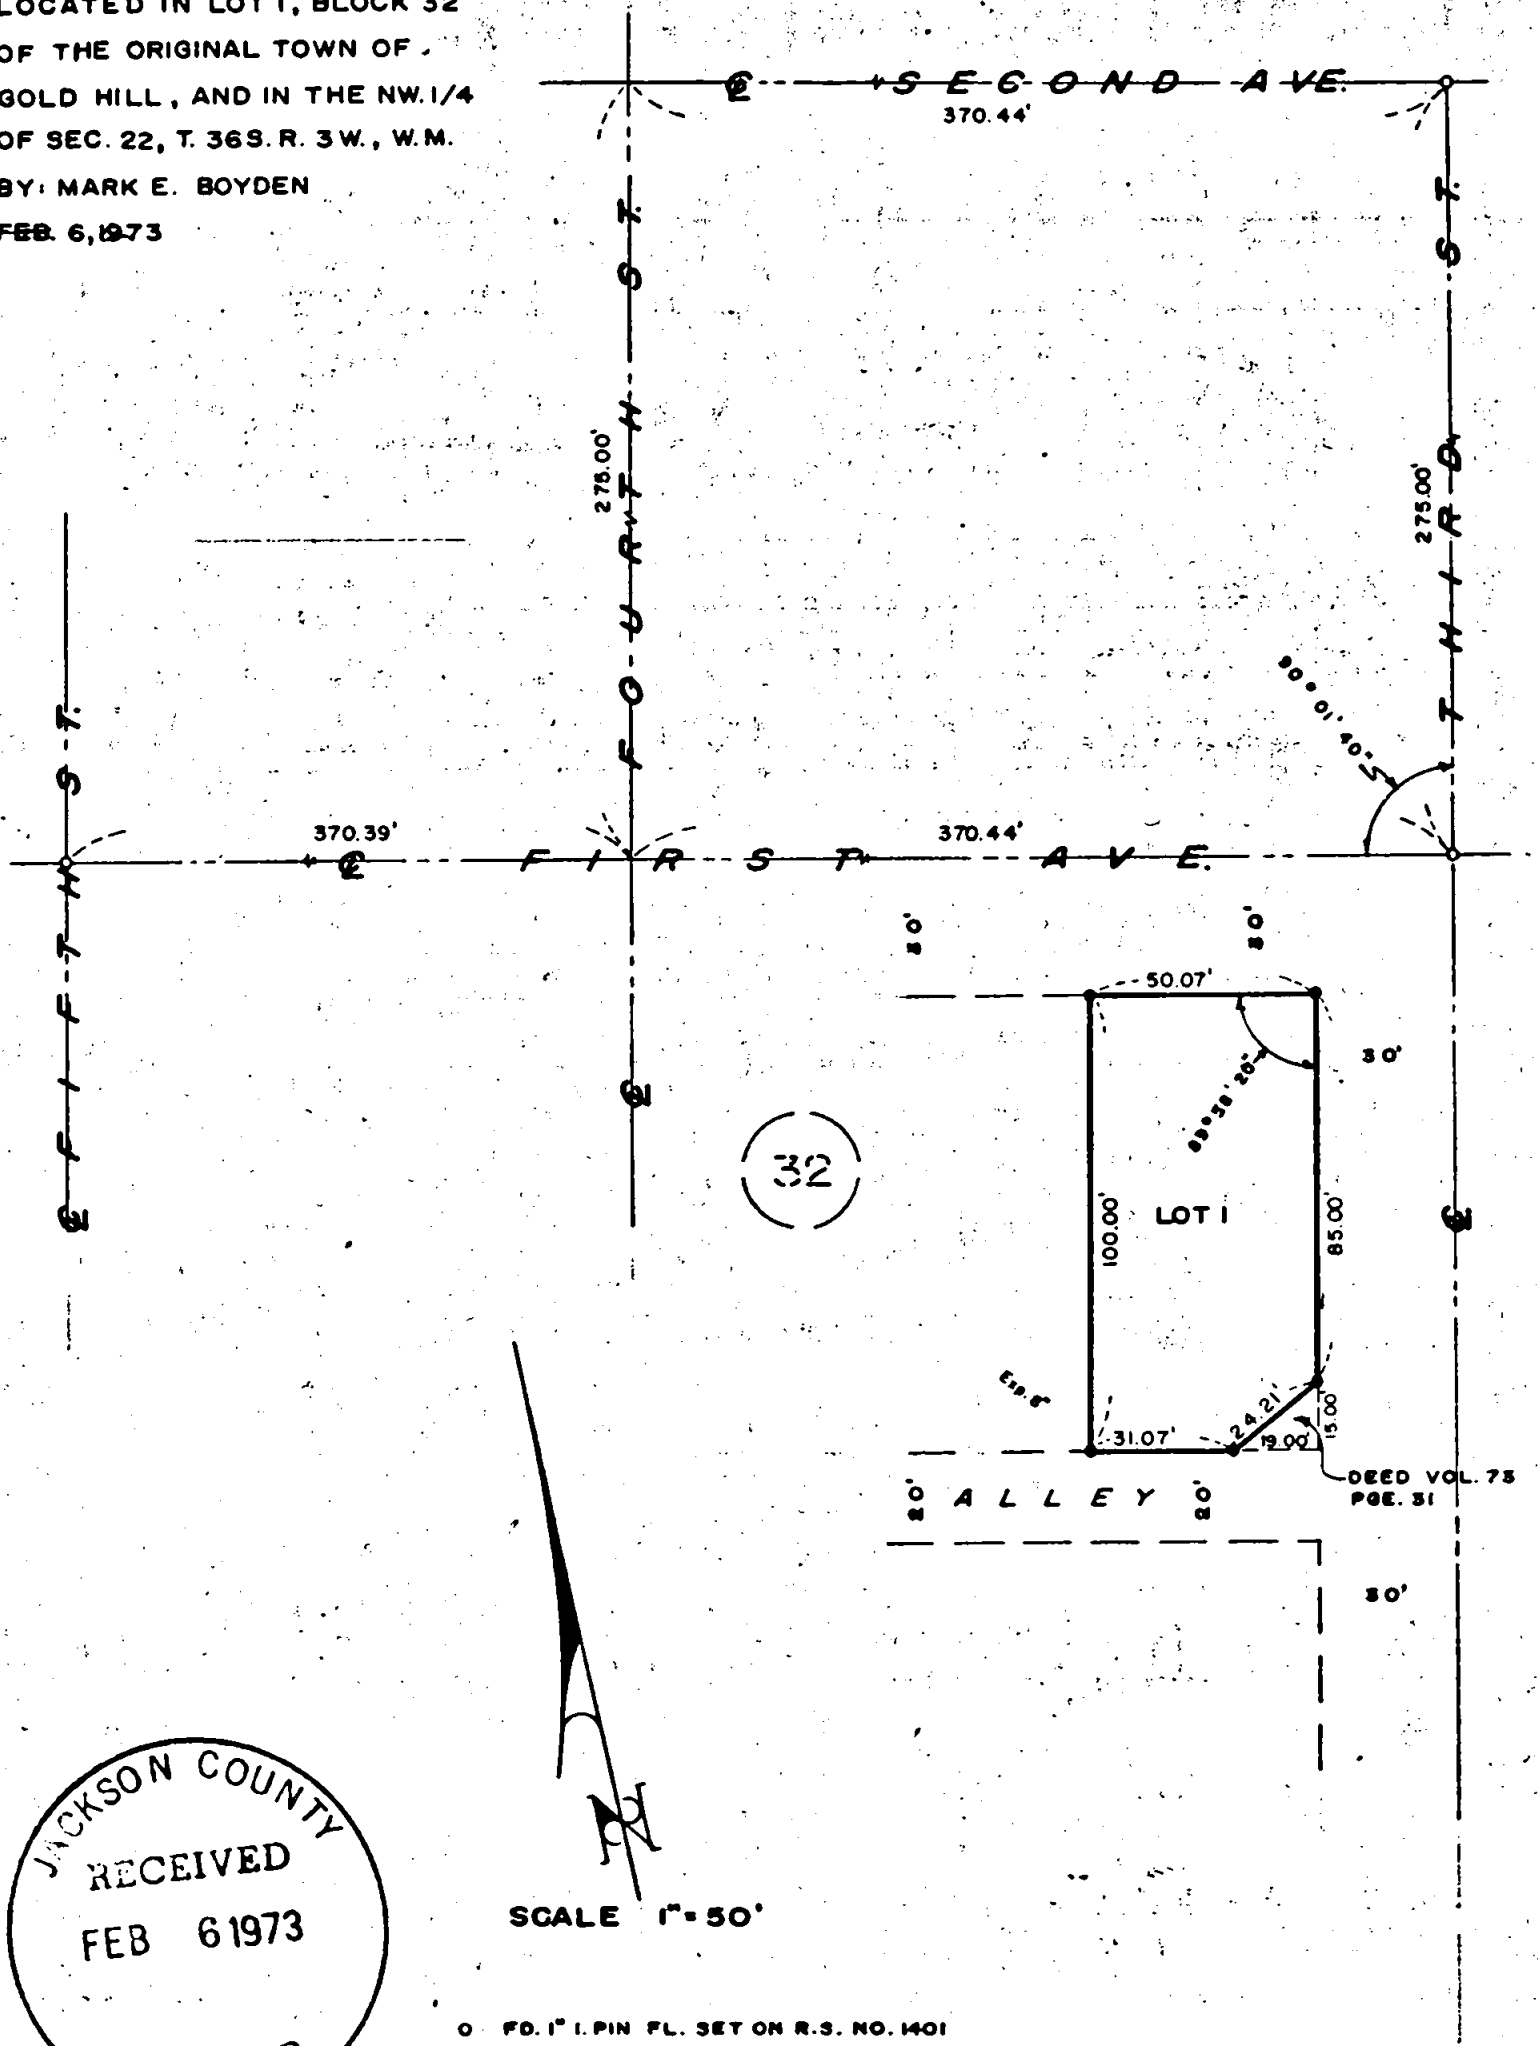

JACKSON COUNTY
RECEIVED
FEB 6 1973
SURVEYOR

SCALE 1" = 50'

- FD. 1" I. PIN FL. SET ON R.S. NO. 1401
- SET 3/4" x 24" I. PIN FL. UNLESS OTHERWISE INDICATED

REGISTERED
PROFESSIONAL
LAND SURVEYOR

Mark E. Boyden

OREGON
NOV 9 1951
MARK E. BOYDEN
281

SURVEY NO. 5079

SURVEY NARRATIVE TO COMPLY WITH O. R. S. 209.250

FOR: Earl Cox
13611 Highway 234
Gold Hill, Oregon 97525

PURPOSE: To monument the corners of tract described in Instrument No. 71-04098 of the Official Records of Jackson County, Oregon, being all of Lot 1, Block 32 of the Original Town (now City) of Gold Hill, excepting that portion conveyed to the City of Gold Hill as described in Volume 73, Page 31 of the Deed Records of said County.

PROCEDURE: Found Street centerline monuments established for the City on Recorded Survey No. 1401. From said controls, extended same Southerly plat record distance and then monumented the desired tract as shown on the map to accompany this report.

February 6, 1973

