

REGISTERED  
 PROFESSIONAL  
 LAND SURVEYOR

*G. W. Plumb*

OREGON  
 JULY 12, 1968  
 G. W. PLUMB  
 862

- BEARINGS FROM R S 3768
- FOUND 5/8" IRON ROD
  - SET 5/8" X 24" IRON ROD

PROPERTY SURVEY

SITUATE IN

NW 1/4 SEC 4 T 35 S R 4 W WM

JACKSON COUNTY OREGON

G W PLUMB LAND SURVEYOR MEDFORD OREGON  
 SCALE 1" = 100' 20 FEB 1973



JACKSON COUNTY  
 RECEIVED  
 FEB 21 1973  
 SURVEYOR

Survey for: Appleton Realty Company  
P. O. Box 388  
Rogue River, Oregon 97537

Survey by G. W. Plumb, Land Surveyor  
P. O. Box 904  
Medford, Oregon 97501

Location: NW 1/4 Section 4, T. 35 S., R. 4 W., W.M.

Found all iron rods set for corners of parcel of land per Registered  
Survey No. 4915. Set two 5/8" x 24" iron rods to divide the parcel into  
two smaller parcels as shown on the accompanying map.

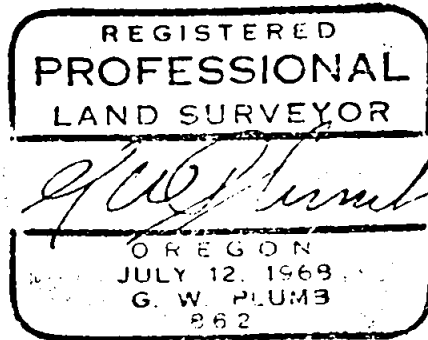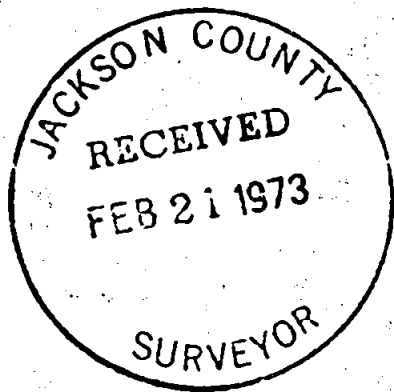

T35 S4 R4W