

JACKSON COUNTY  
RECEIVED  
MAR 20 1973  
SURVEYOR

REGISTERED  
PROFESSIONAL  
LAND SURVEYOR  
*Edward A. McGinty*  
OREGON  
JULY 10 1972  
EDWARD A. MCGINTY  
301

SURVEY IN NW 1/4 SEC. 26 T38S R1W WM. 1/4

FOR  
VILMOS VEKONY

72-49

BY EDWARD MCGINTY  
MEDFORD OREGON  
NOVEMBER 1972

SCALE 1" = 100'  
O = FD. 5/8" I. PIN  
X = FD. SPIKE  
● = SET 5/8" I. PIN  
X = FD. 2" PIPE

SURVEY NUMBER 5128

SURVEY NARRATIVE TO COMPLY WITH O.R.S. 209-250

Survey for: Vilmos Vekony 72-49  
526 Wagner Ck. Rd.  
Talent, Oregon 97540

Survey by: Edward A. McGinty, R.S.  
Medford, Oregon  
December, 1972

Basis of Bearing: B.C.V.S.A. Datum

Location: N.W. 1/4 Sec. 26, T38S, R1W, W.M.  
Talent, Oregon



Precedence of Survey:

The purpose of this survey was to divide the tract described in deed record, Vol. 317, page 35. This survey is in no way to be construed to show the exterior of said tract but to show monuments as found on a previous survey by persons unknown and to show monuments shown on Survey No. 3060.

The Northerly line as shown agrees reasonably close to the line of occupancy by adjacent owners but the preliminary data compiled as to the location of D.L.C. corner could vary this line about 20 feet to the South.

The center line shown on Survey No. 3060 on the East-West section of Wagner Creek Road is on County 'P' Line. The center on Survey No. 3653 and on this survey being on County 'L' Line. This data confirmed by the County Road Department as County Road 'L' Line.

It is recommended boundary line agreement or suit to quit title along the Northerly and Westerly line of tract as occupied.

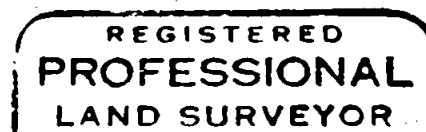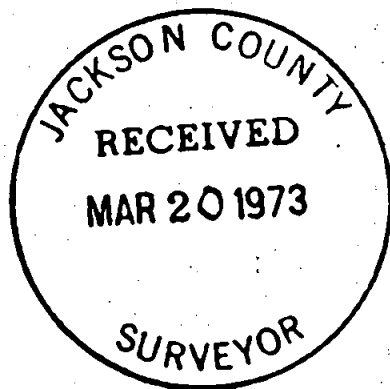

T38 S26 R1W