

SURVEY FOR:


GILBERT C. BOWERS

LOCATED IN D.L.C. NO. 52  
IN THE NW 1/4 OF SEC. 29,  
T. 37 S. R. 1 W., W.M.  
MEDFORD, OREGON  
BY: MARK E. BOYDEN  
MARCH 23, 1973

NW. Cor. D.L.C. No. 52  
Fd. Br. disk in conc. in mon. case

NW. Cor. Lot 1, Block 2 EAST HEIGHTS  
ADD. Fd. Br. disk in conc. in mon. case

S 89° 55' E

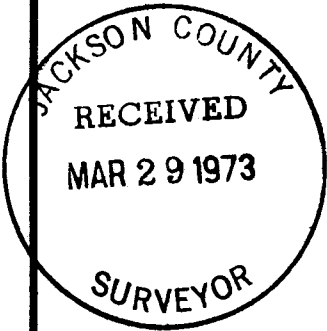

SCALE 1=50'  
BASIS OF BEARINGS

RECORDED SURVEY NO. 2354

- SET 3/4" x 24" I.PIN FLUSH UNLESS OTHERWISE INDICATED
- FOUND 3/4" I. PIPE FLUSH

REGISTERED  
PROFESSIONAL  
LAND SURVEYOR

*Mark E. Boyden*  
OREGON  
NOV 9, 1951  
MARK E. BOYDEN  
281

NE. Cor. D.L.C. No. 44  
Fd. Br. cap in conc.

Fd. 3/4" I. pipe in conc.  
SW. cor. Block 2 Amended  
Plat of CROWN HEIGHTS ADD.

SURVEY NARRATIVE TO COMPLY WITH O. R. S. 209.250

FOR: Gilbert C. Bowers  
271 Black Oak Drive  
Medford, Oregon 97501

PURPOSE: To monument and describe in 2 parcels, the Bowers ownership described in Instrument No. 71-15895 of the Official Records of Jackson County, Oregon, being located in the NW 1/4 of Section 29, T37SR1W, W. M..

PROCEDURE: Utilizing a one-second theodolite, an electronic measuring instrument and chain, tied to monuments as shown on the map to accompany this report.  
  
From said data, set monuments at positions as shown on said map.

March 23, 1973

