

SURVEY FOR:

TERRY GREEN

LOCATED IN THE
SOUTH-HALF OF SEC.16,
T. 36 S.R. 1 W., W.M.

BY: MARK E. BOYDEN

OCT. 9, 1972

AVE. "H"

Fd. 1/2" l. pin fl.

265.00'

Set 3/4" x 30" l. pin exp. 8"

*Proposed Desert Palms
Subdivision*

293.72'

Proposed Boundary Line Agreement

(Record R.S. No. 1964=N 0° 11' 20" W) N 0° 10' 10" W

Fd. 5/8" l. pin exp. 3"

80'

AVENUE "G"



P.O.B. is 4157.97' North and
2640.38' East from 1/4 cor.
common to Sec's. 20 & 21,
T. 36 S. R. 1 W.

SCALE 1"=100'

BASIS OF BEARINGS

CASCADE VILLAGE, UNIT NO. 3 (Recorded)

Rotated 0° 00' 40" Clockwise

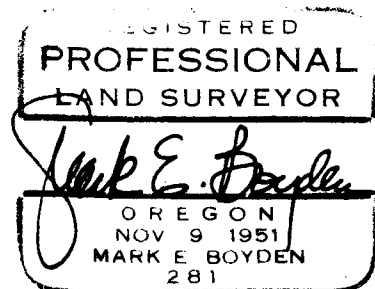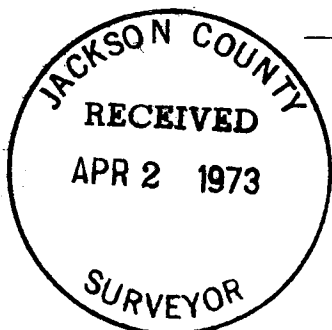

5155

SURVEY NO. _____

SURVEY NARRATIVE TO COMPLY WITH O. R. S. 209.250

FOR: Terry Green
P.O. Box 315
Medford, Oregon 97501

PURPOSE: To monument and describe a boundary proposed to be established by a recorded boundary line agreement between the properties of Ted Hornecker and Maynard W. Hadley, Jr., being located in the South-half of Section 16, T36SR1W, W. M..

PROCEDURE: Utilizing a one-second theodolite, an electronic measuring instrument and chain, tied from the concrete monument with bronze disk at the 1/4 corner common to Sections 20 and 21 to monuments found or set on Recorded Survey No. 1964 as shown on the map to accompany this report. From said data, set a 3/4" iron pin for the Northerly terminus of said proposed boundary line agreement.

October 9, 1972

