
6170

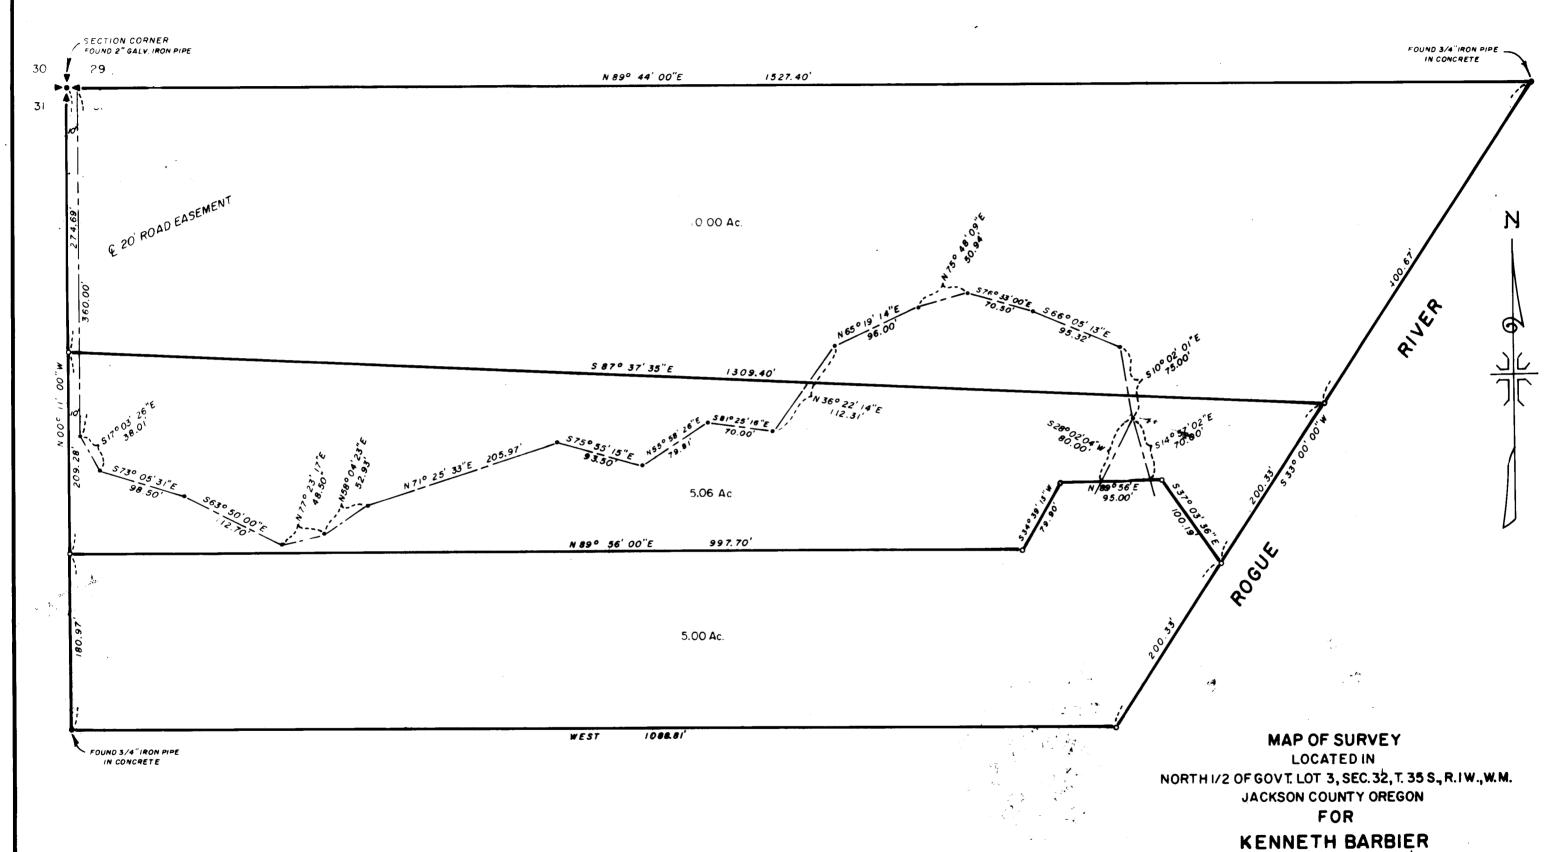

PROFESSIONAL
LAND SURVEYOR

C. A T LL

OREGON
NOV. 7. 1947
J. A. HOFFBUHR
223



5170

.. A. HOFFBUHR, REG. L.S., MEDFORD, OREGON

-SET 5/8" X 24" IRON REINFORCING PIN

JULY 31, 1972

R/3 NO. 686

``A'.E:I"=100'

- 13 OF BEARING ~

SURVEY NARRATIVE TO COMPLY WITH PARAGRAPH 209.250 OREGON REVISED STATUTES

SURVEY FOR:

Mr. Kenneth Barbier

2450 Boardman Drive

Palm Springs, California

LOCATION:

Tract situated in the Northwest One Quarter (1/4) of

Section 32, Township 35 South, Range 1 West, Willamette

Meridian, Jackson County, Oregon.

PURPOSE:

To partition into tracts the overall parcel indicated

on the attached map.

PROCEDURE: The survey control developed for Recorded Surveys Nos.

3021, 4291 (Alan Lowry Survey No. ?) were used for the purpose of establishing the boundaries of the overall tract. Basis of bearing--Recorded Survey No. 3021.

March 12, 1973



J. A. Hoffbuhr
Professional Land Surveyor

