
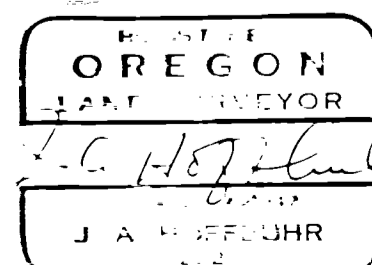


MAP OF SURVEY  
 LOCATED IN  
 S. E. 1/4 OF SECTION 33 & D.L.C. NO. 95, T. 37 S., R. 2 W., W.M.  
 JACKSON COUNTY OREGON  
 FOR  
 GORDON GREEN

J. A. HOFFBUHR, REG. L.S., MEDFORD, OREGON  
 SCALE: 1"=50' JULY 27, 1971  
 BASIS OF BEARING - SOLAR OBSERVATION  
 @ SET 5/8" X 24" IRON REINFORCING PIN

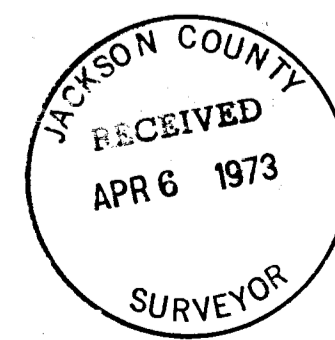

ARNOLD LANE

SURVEY NARRATIVE TO COMPLY WITH PARAGRAPH 209.250  
OREGON REVISED STATUTES

SURVEY FOR: Mr. Gordon Green  
511 So. Fir Street  
Medford, Oregon

LOCATION: Tract situated in the Southeast One Quarter (1/4) of Section 33, and the Southwest One Quarter (1/4) of Section 34, Township 37 South, Range 2 West, Willamette Meridian, in Jackson County, Oregon.

PURPOSE: To retrace an unrecorded survey, and to prepare a legal description of the tract shown on the attached map.

PROCEDURE: The control for this survey was developed by using a set of Tellurometers and T-2 Wild Theodolite. The client furnished a map prepared by L. E. Ager, (Deceased), of a survey showing the tract to be surveyed and other tracts of land. The client directed this survey and requested the survey along the Southerly and Easterly lines to follow the random pins established by the previous survey. The Northerly line to follow the existing fence line to avoid the encroachment shown on the map. The Westerly line to be situated on the title line which did not agree with the fence line. Basis of bearings - - Solar observation.

November 27, 1972

J. A. Hoffbuhr  
Professional Land Surveyor

