

MAP OF SURVEY
 LOCATED IN
 S.W. 1/4 OF SEC. 30, TWR 37S., R. 1W., W.M.
 JACKSON, COUNTY OREGON
 FOR

REGISTERED
 PROFESSIONAL
 LAND SURVEYOR


Everett L. Swain
 OREGON
 JULY 8 1966
 EVERETT L. SWAIN
 759

REALESTATERS, INC.

EVERETT L. SWAIN, R.L.S. ASHLAND, OREGON

SCALE: 1" = 40' MARCH 23, 1973
 BASIS OF BEARING RECORDED SURVEY No. 3571

- FOUND 5/8 INCH IRON PIN
- ⊙ FOUND & STREET MONUMENT WITH A POINTED IRON PIN IN CONCRETE
- SET 5/8 x 24 INCH IRON PIN WITH ALUMN. CAP

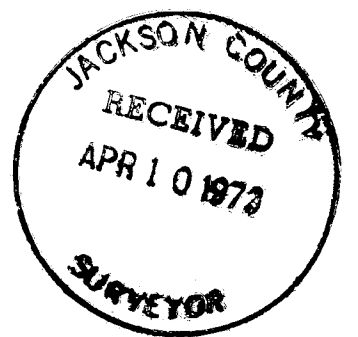

SURVEY NARRATIVE TO COMPLY WITH PARAGRAPH 209.250
OREGON REVISED STATUTES

- SURVEY FOR: Realestaters, Inc.
c/o Marquess & Marquess, Engineers
Goldy Building
Medford, Oregon 97501
- LOCATION: Situated in the Southwest quarter of Section 30, Township 37 South,
Range 1 West of the Willamette Base and Meridian, Jackson County,
Oregon.
- PURPOSE: To survey and monument those tracts as shown on the accompanying map,
per instructions received from C. P. Westwood of Marquess & Marquess,
Engineers, Medford, Oregon.
- PROCEDURE: Commenced this survey in the vicinity of Twelfth Street and South
Riverside Avenue. Found survey monuments per recorded survey no. 1616
and 3571. The street centerline control and the survey monuments were
correlated with the Deeds of Record. After a complete evaluation of all
the data compiled, set the property corners as shown on the accompanying
map. The control angles were turned with a Wild T-2 Theodolite and the
distances measured with a Hewlett-Packard 3800A Distance Meter, all in
good adjustment.

March 23, 1973

Everett L. Swain
Professional Land Surveyor
Ashland, Oregon

