

PROPERTY SURVEY

SITUATE IN

SE 1/4 SEC 8 T 35 S R 4 W WM

JACKSON COUNTY OREGON

G W PLUMB LAND SURVEYOR

MEDFORD OREGON

SCALE 1" = 100'

16 APRIL 1973



BEARINGS FROM RS 121


● FND 5/8" IRON ROD

○ SET 5/8" X 24" IRON ROD

REGISTERED  
**PROFESSIONAL**  
 LAND SURVEYOR

*G. W. Plumb*

OREGON  
 JULY 12, 1968  
 G. W. PLUMB  
 862

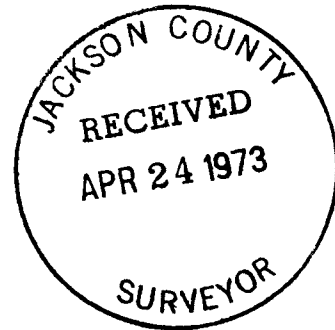

Survey for: W. W. Owings  
8105 West Evans Creek Road  
Rogue River, Oregon 97537

Survey by: G. W. Plumb, Land Surveyor  
P. O. Box 904  
Medford, Oregon 97501

Location: S.E.  $\frac{1}{4}$  Sec. 8, T. 35 S., R. 4 W., W.M.

Found brass cap monument for corner of Sections 8, 9, 16 and 17. Found 5/8" iron rods set per Registered Survey No. 5138, on the E. - W. sixteenth section line of the S.E.  $\frac{1}{4}$  of Sec. 8. Set 5/8" x 24" iron rods to delineate parcel of land as requested by owner.

19 April 1973

