
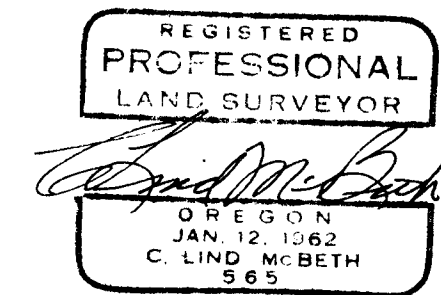


Scale: 1" = 50'
 • = Set iron pin
 ○ = Found iron pin

Survey for: Mr. Edwin Shipley
 Situated in: SW 1/4, SE 1/4, Section 30, Township 37
 South, Range 2 West of the Willamett Meridian,
 Jackson County, Oregon.
 By: C. Lind McBeth, L.S., Jacksonville, Oregon.
 Date: March 17, 1973

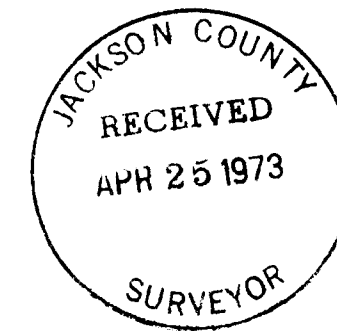

Survey Narrative to comply with O.R.S. 209-250

Survey for: Mr. Edwin Shipley
310 Mary Ann Dr.
Jacksonville, Oregon

Date: April 20, 1973

Survey Location: S.E. 1/4 , of Sec. 30, T 37S , R2W, W.M.
Jackson County, Oregon

Basis of Bearing ; R.S. No. 3454

Survey By; C. Lind McBeth
P.O.Box 306
Jacksonville, Oreg.

Survey Procedure;

Found the Northeast corner and Southeast corner of the Shipley property, also found the Northwest corner of the property described in Vol.388, Pg.124 Having this control as set forth in R.S. #3454 I subdivided this parcel as directed by my client; and set iron pins as shown on the accompanying plat.

