RECEIVED MAY 3 1 1973

SURVEYOR

SURVEY PLAT & NARRATIVE TO COMPLY WITH PARAGRAPH 209.250. OREGON REVISED STATUTES

Joe & Ruth Jarvis Survey for:

Survey by:

Charles H. Hurst

410 North Main Phoenix, Oregon 23 North Ivy Medford, Oregon

Based on the meridian for Recorded Survey No. 1427.

Bearing

Purpose

To monument the corners of the tract shown.


Procedure :

Continuation & utilization of survey control established during the course of Recorded Survey No. 4891. All lines were double measured including the tie to the ${\tt NE}$ corner of

DLC 77 in view of measured discrepancies with existing

fence lines.

SURVEY IN DONATION LAND CLAIM NO. 77 (E 1/2 NE 1/4 Sec. 35) T. 37 S., R. 2 W., W.M. Jackson County, Oregon.

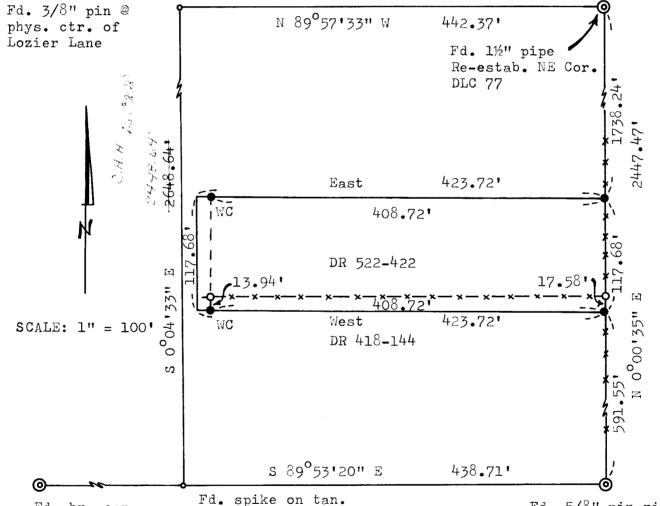

Fd. br. cap in mon. case SW cor. DLC 77 Phys. ctr. Lozier Lane

Fd. 5/8" pin riser in pipe SE cor. DLC 77 by proportion

LEGEND

- Set 5/8" x 24" iron pins
- o 5/8" pins set on fence line
- -x- Existing fences

REGISTER D ROFESSIONAL LAND SURVEYOR

Charles V. Kurst

OREGON OCTOBER 30, 1959 CHARLES H. HURST 483

APR 2 0 1973

5245