5248

SURVEY PLAT & NARRATIVE TO COMPLY WITH PARAGRAPH 209.250, OREGON REVISED STATUTES

Survey for: Lewis Deluca
8217 Wagner Crk. Rd.
Talent, Oregon 97540

Survey by : Charles H. Hurst, L.S.
23 North Ivy
Medford, Oregon 97501

Bearing : Based on the meridian for Recorded Survey # 2750

Purpose : To separate the tract shown

Procedure : Geodimeter, transit & tape. Monuments for unrecorded survey held for control as found.

SURVEY SITUATE IN GOV'T. LOT 1 & THE SE¼SW¼ OF SEC. 35, T. 38 S., R. 1 W., W.M., JACKSON COUNTY, OREGON.

SCALE: 1" = 60'

JACKSON COUNTY
RECEIVED
MAY 31 1973
SURVEYOR

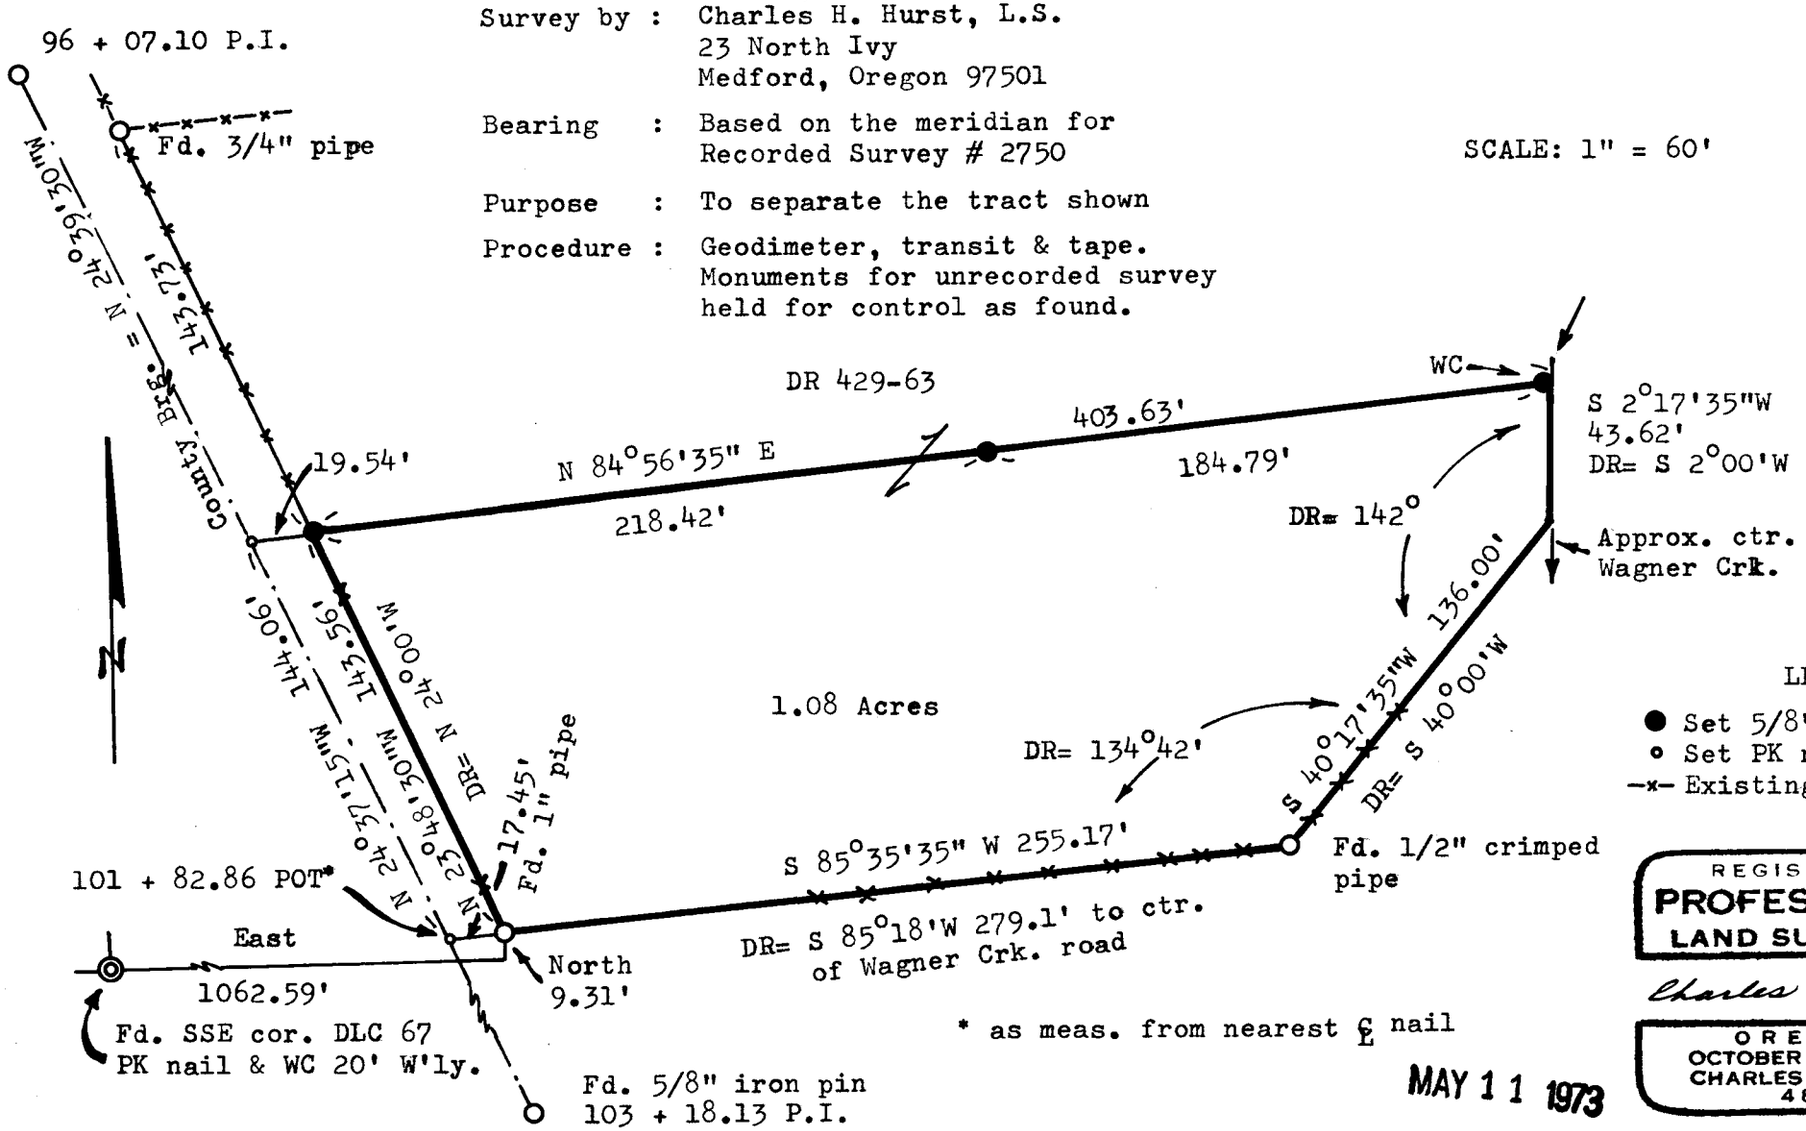

LEGEND

- ● Set 5/8" x 24" iron pins
- ○ Set PK nails on ℄
- —x— Existing fence lines

* as meas. from nearest ℄ nail

REGISTERED
PROFESSIONAL
LAND SURVEYOR

Charles H. Hurst

OREGON
OCTOBER 30, 1959
CHARLES H. HURST
483

MAY 11 1973

5248