


5249
6429

SURVEY PLAT & NARRATIVE TO COMPLY WITH
PARAGRAPH 209.250, OREGON REVISED STATUTES

Survey for: Virginia W. Cotton Survey by: Charles H. Hurst
1120 Prospect Avenue 23 North Ivy
Ashland, Oregon 97520 Medford, Oregon 97501


Purpose : To monument the division line shown.
Procedure : Extension of control established during
the course of Recorded Survey # 2486.
Bearing : Solar observation.

9 10
16 15
Fd. Sec. Cor.
1" x 1" iron
bar
N 0°08' E

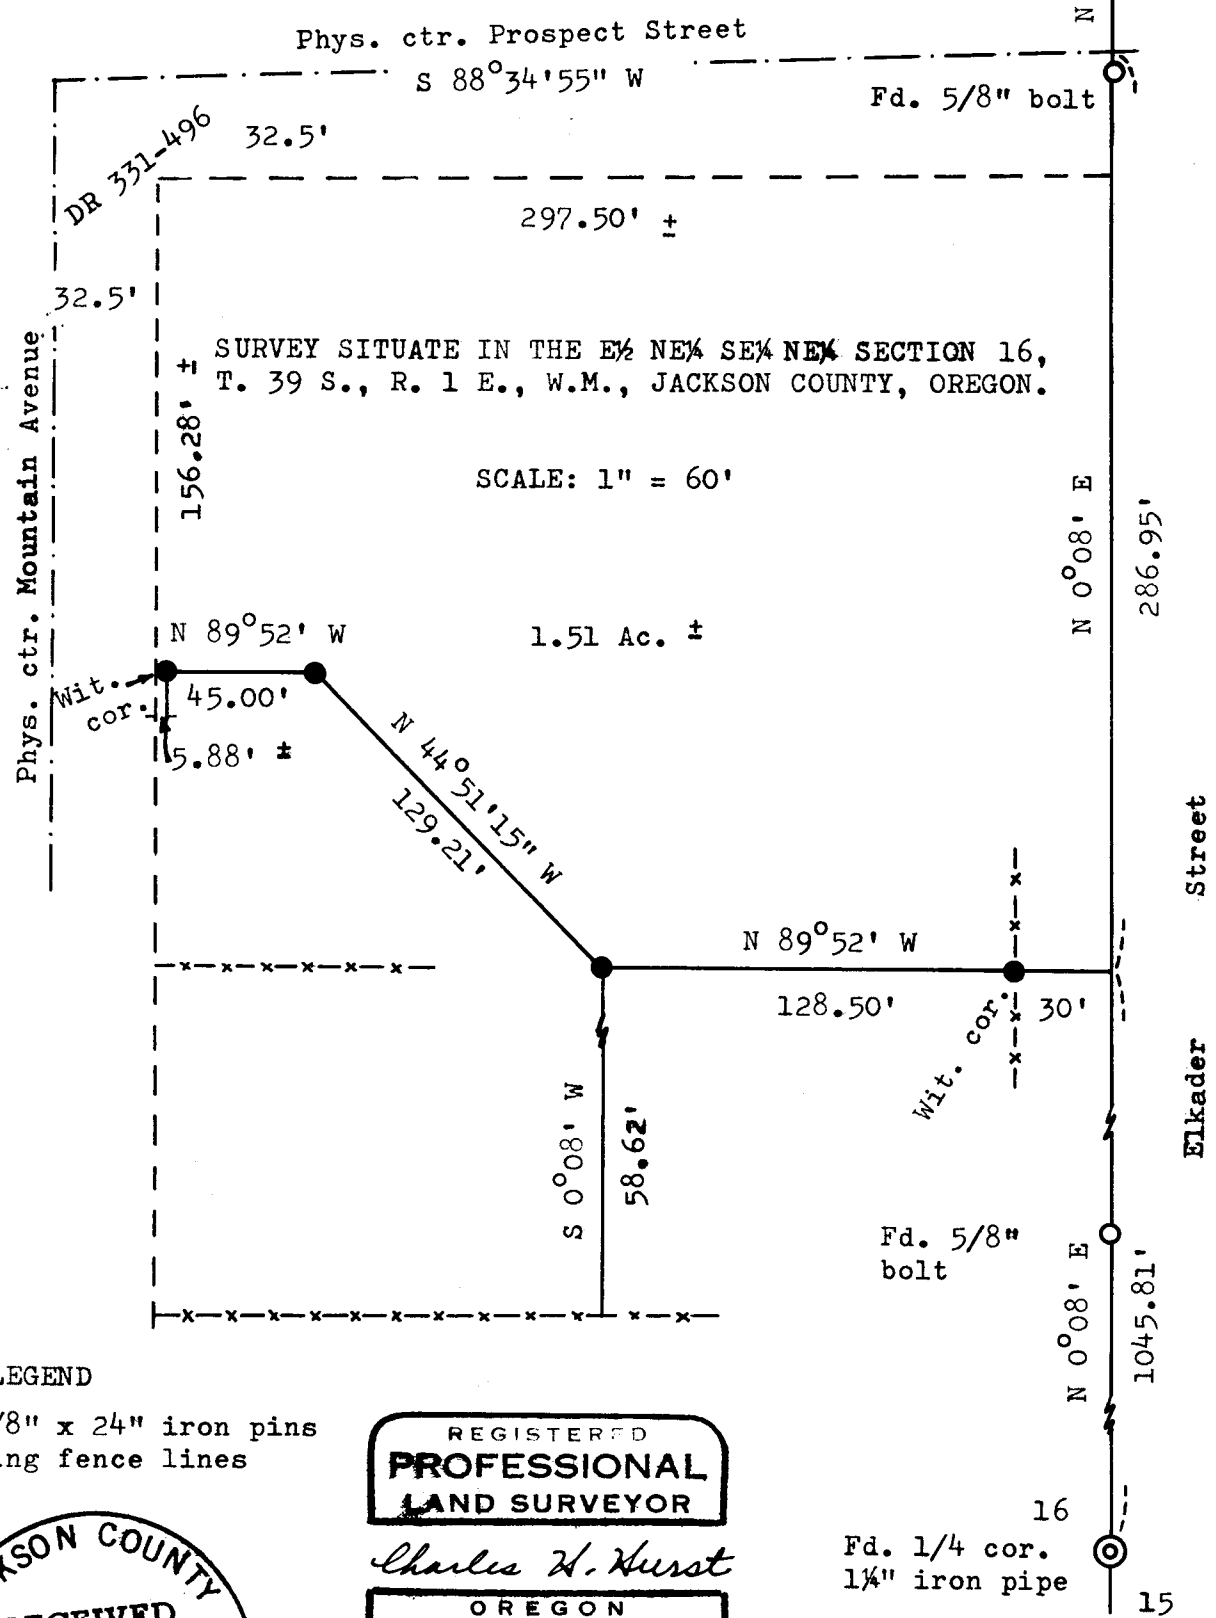

LEGEND

- Set 5/8" x 24" iron pins
- x- Existing fence lines

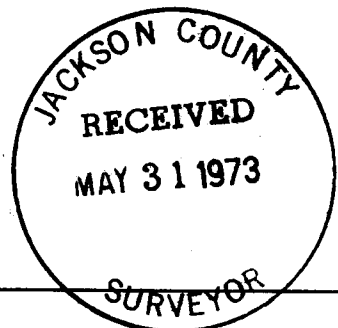

REGISTERED
**PROFESSIONAL
LAND SURVEYOR**
Charles H. Hurst
OREGON
OCTOBER 30, 1959
CHARLES H. HURST
483

MAY 10 1973