


SCALE 1" = 300'

BEARING'S BASED ON THE NORTH LINE OF THE SW 1/4 OF SECTION II, AS PER RECORDED SURVEY #4855

- ⊙ = CORNER FOUND
- = CORNER SET (5/8" IRON ROD)

SURVEY
 IN
 SECTION II, T. 35 S., R. 4 W., WM.
 JACKSON COUNTY, OREGON
 for
 MR. EARL QUICK
 790 COVERED BRIDGE RD.
 WIMER, OREGON

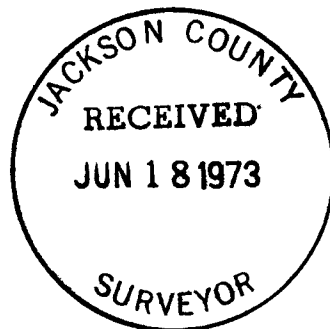

PER E. ZIMMERLUND
 CONSULTING ENGINEER
 ROGUE RIVER, OREGON
 W.O. 279 JUNE 14, 1973

SURVEY NARRATIVE TO COMPLY WITH PARAGRAPH 209.250 O. R. S.

SURVEY FOR: Earl Quick
790 Covered Bridge Road
Rogue River, Oregon 97537

LOCATION: Southeast Quarter, Section 11, Township 35 South,
Range 4 West of Willamette Meridian, Jackson
County, Oregon.

PURPOSE: To survey and monument a parcel of land in said
Southeast Quarter containing approximately 9 acres.

PROCEDURE: Beginning at the Center Quarter Corner of Section 11
monumented with a stone and 2 bearing trees per Re-
corded Survey No. 4855; thence I run South 89°09'33"
East 1316.32 feet single proportionate measurement
to the CE 1/16 Corner at which point I set a 5/8" x
30" iron rod from which:


1. A cottonwood 30" diameter bears North 12°
East 49.12 feet marked CE 1/16 RE 5685 BT
2. An ash 28" diameter bears South 87° East
15.35 feet marked CE 1/16 RE 5685 BT

Thence I continue South 89°09'33" East 1316.32 feet
single proportionate measurement to the Quarter
corner common to Sections 11 and 12 monumented with
a 2 1/2" diameter brass cap and bearing trees per 1960
County Surveyor Renewal;

Thence I return to the before described CE 1/16 Corner
and run North 89°09'33" West 128.09 feet; at which
point I set a 5/8" x 30" iron pipe; thence I continue
North 89°09'33" West for 140± feet to the centerline
of Evans Creek; thence I run South 43°31'10" West
along the centerline of Evans Creek 214± feet; thence
I run South 1°14'35" East 185± feet at which point I
set a 5/8" x 30" iron rod; thence I continue South
1°14'35" East 184.37 feet, at which point I set a
5/8" x 30" iron rod; thence I run South 49°58'50" East
246.95 feet at which point I set a 5/8" x 30" iron
rod; thence I run South 4°35'37" West 600.00 feet,
at which point I set a 5/8" x 30" iron rod.

All bearings are based on the North line of the South-
west Quarter of said Section 11 as per Recorded Survey
No. 4855.

Survey was executed with a Wild T16ED Transit
Theodolite and 200.00 foot steel chain.

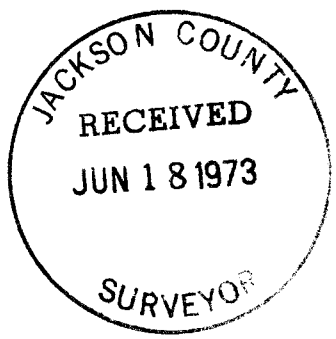

June 14, 1973

