


65 54

293  
5293-F

T. 37 S., R. 5 W., N. MERIDIAN, ORE.  
DEPENDENT RESURVEY OF PART OF BORGS AND  
SUBDIVISION OF SECS. 25 AND 36.

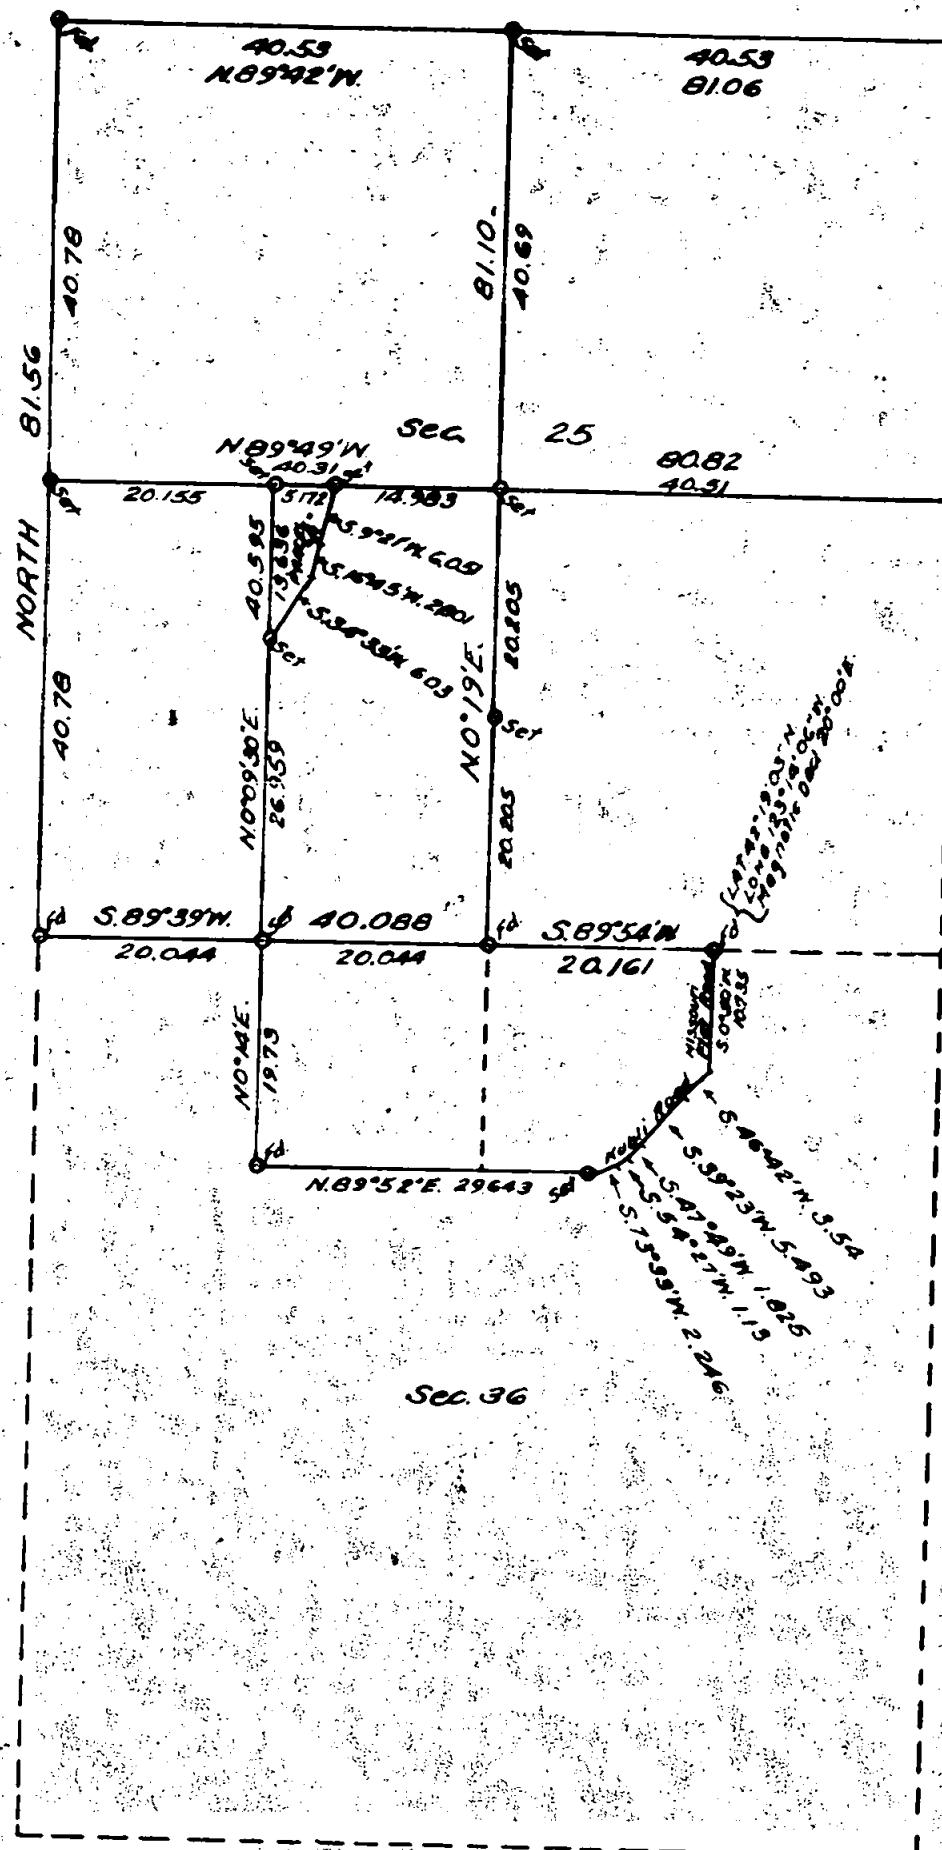

Scale: 1 in = 20 chs = 1320 ft. The bearings of all lines are referred to the true Mean Magnetic Declination 19° 57'E. meridian determined by Solar observations.


Survey executed July 23-August 5, 1954 for Col. LeRoy G. Heston  
of Grants Pass, Ore.

I hereby certify that the survey represented by this plot is  
executed in conformity with the laws of the State of Oregon.

Area of Parcel "A" in Sec 25 = 4.67 A.  
Area Surveyed in Sec. 36 = 75.43 A.

REGISTERED  
OREGON  
LAND SURVEYOR

JULY 7 1944  
NORMAN D. PRICE  
No. 33

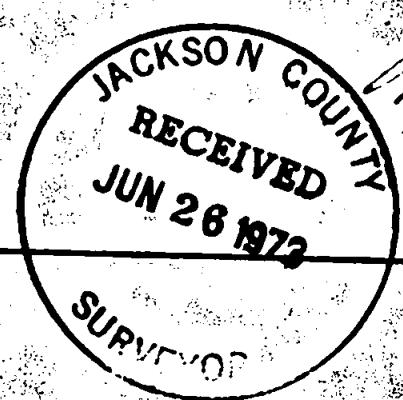

not

65 54

5283

5293-E

6

T. 37 S., R. 5 W.

I hereby certify that the bearings of all lines recorded  
in this survey were determined by solar observations  
and that the survey described in the foregoing field  
notes was executed in conformity with the laws of the  
State of Oregon.

Grants Pass, Oregon,  
August 7, 1954.


REGISTERED  
OREGON  
LAND SURVEYOR

*Norman D. Price*

JULY 7, 1944  
NORMAN D. PRICE  
No. 33

*Norman D. Price*

Norman D. Price,  
Registered Professional  
Land Surveyor for Oregon,  
No. 33.

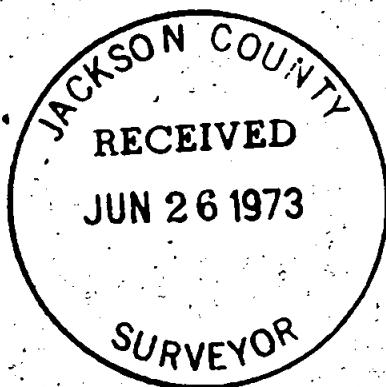

65 54

5293

5293-D

5

T. 37 S., R. 57.

Chains

A black oak, 20 ins. diam., bears N. $19\frac{1}{2}$ E., 73 lks.  
dist., mkd. CW 1/16 S25 RS33 BT.

A white oak, 40 ins. diam., bears N. $72^{\circ}$ E., 86 lks.  
dist., mkd. CW 1/16 S25 RS33 BT.

80.82 The  $\frac{1}{4}$  sec. cor. of secs. 25 and 26.

From the W1/16 sec. cor. of secs. 25 and 36,

N.  $0^{\circ} 09' 30''$  E., on the N. and S. center line of the  
SW $\frac{1}{4}$  of sec. 25.

40.595 The center W.1/16 sec. cor. of sec. 25.

---

Survey of Parcel "A" in NE $\frac{1}{4}$  of SW $\frac{1}{4}$  of Sec. 25.

---

Beginning at a point on the N. and S. center line of SW $\frac{1}{4}$   
of sec. 25, from which the center W. 1/16 sec. cor. of  
sec. 25 bears N.  $0^{\circ} 09' 30''$  E., 13.636 chs. (900.00 ft.)  
dist.

Thence

N.  $0^{\circ} 09' 30''$  E., along N. and S. center line of SW $\frac{1}{4}$  of  
sec. 25 and W. bdy. of parcel "A" of sec. 25.

13.636 The center W. 1/16 sec. cor. of sec. 25.

Thence

S.  $89^{\circ} 49'$  E., on E. and W. center line of sec. 25 and N.  
bdy. of parcel "A" of sec. 25.

5.172 NE. cor. of parcel "A" of sec. 25.

Set an iron pipe, 3 ft. long, 1 in. diam., 28 ins. in the  
ground, mkd. RS33; from which

A white oak, 8 ins. diam., bears S. $27\frac{1}{2}$ E., 40 lks.  
dist., mkd. RS33 BT.

A white oak, 8 ins. diam., bears S. $68\frac{3}{4}$ W., 30 lks.  
dist., mkd. RS33 BT.

Thence with traverse of easterly bdy. of parcel "A" of sec.  
25; along top of bank of Miller Creek.

S.  $9^{\circ} 21'$  W., 6.051 chs.

S.  $16^{\circ} 45'$  W., 2.801 chs.

S.  $34^{\circ} 33'$  W., 6.03 chs. At end of course, the point of  
beginning, where

Set an iron pipe, 3 ft. long, 1 in. diam., 28 ins. in the  
ground, mkd. RS33, for southerly cor. of parcel "A" of  
sec. 25; from which

A madrona, 10 ins. diam., bears S. $68^{\circ}$ E., 35 lks.  
dist., mkd. RS33 BT.

A white oak, 12 ins. diam., bears S. $15\frac{3}{4}$ E., 65 lks.  
dist., mkd. RS33 BT.

Containing 4.67 acres.

---

T. 37 S., R. 5 W.

--5293

## Chains

5293-C

sec. cor. of sec. 36 bears S.  $89^{\circ} 52'$  W., 29.643 chs.  
dist.

The tract of land surveyed in sec. 36 contains 75.43 acres.

## Subdivision of Sec. 25.

From the  $\frac{1}{4}$  sec. cor. of secs. 25 and 36,N.  $0^{\circ} 19'$  E., on the N. and S. center line of sec. 25.Along a dilapidated old fence that crosses and re-crosses  
line.20.205 Point for the center S.  $1/16$  sec. cor. of sec. 25.Set an iron pipe, 3 ft. long, 1 in. diam., 28 ins. in the  
ground, mkd. RS33.40.41 Point for center  $\frac{1}{4}$  sec. cor. of sec. 25 at intersection  
with the E. and W. center line.Set an iron pipe, 3 ft. long,  $1\frac{1}{2}$  ins. diam., 28 ins. in the  
ground, mkd. RS33; from whichA madrona, 16 ins. diam., bears S.  $27\frac{1}{2}^{\circ}$  W., 125 lks.  
dist., mkd. C  $\frac{1}{4}$  S25 RS33 BT.A madrona, 13 ins. diam., bears S.  $56\frac{1}{2}^{\circ}$  W., 42 lks.  
dist., mkd. C  $\frac{1}{4}$  S25 RS33 BT.81.10 The  $\frac{1}{4}$  sec. cor. of secs. 24 and 25.

-----

The locus of the  $\frac{1}{4}$  sec. cor. of secs. 25 and 30, on E. bdy.  
of the Tp., is determined at the record distance from  
each of the bearing trees marked by the U.S. surveyor in  
1918; no evidence of the corner stone is found.

At the corner point,

Set an iron pipe, 3 ft. long,  $1\frac{1}{2}$  ins. diam., 28 ins. in the  
ground, mkd. RS33; from which the 1918 bearing trees:A black oak, 16 ins. diam., bears S.  $38^{\circ}$  E., 36 lks. dist.  
with old blazes healed. As the blazes on this tree do  
not approximate facing the corner point, I re-blaze  
and re-mark  $\frac{1}{4}$  S30 RS33 BT.A Douglas fir, 20 ins. diam., bears S.  $29^{\circ}$  W., 60 lks.  
dist., with old blaze burnt.

And a new bearing tree:

A Douglas fir, 12 ins. diam., bears N.  $86^{\circ}$  W., 69 lks.  
dist., mkd.  $\frac{1}{4}$  S25 RS33 BT.

Thence

N.  $89^{\circ} 49'$  W., on the E. and W. center line of sec. 25.Over old placer workings and along a fence which crosses  
and re-crosses line.40.51 Intersect the N. and S. center line at the center  $\frac{1}{4}$  sec. cor.60.665 Point for center W.  $1/16$  sec. cor.Set an iron pipe, 3 ft. long, 1 in. diam., 14 ins. in the  
ground to bedrock and in a mound of stone to top, mkd.  
RS33; from which

## Chains

T. 37 S., R. 5 W.

A Douglas fir, 8 ins. diam., bears N.48°E., 21 lks.  
dist., mkd.  $\frac{1}{2}$  S24 RS33 BT.

A white oak, 16 ins. diam., bears S.47 $\frac{1}{2}$ °E., 19 lks.  
dist., mkd.  $\frac{1}{4}$  S25 RS33 BT.

81.06 The cor. of secs. 23, 24, 25, and 26.

## Subdivision of Sec. 36.

The locus of the NW $\frac{1}{16}$  sec. cor. of sec. 36 is locally accepted at the cor. of substantial fences extending N., E., S., and W. The county surveyor occupied this point in 1922; an unrecorded bearing tree is found as follows:

A black oak, 24 ins. diam., bears S.55°E., 14 $\frac{1}{2}$  lks.  
dist., with blaze healed.

Against N. side of fence corner post, 1 lk. N. of true corner point, set an iron pipe, 3 ft. long, 1 in. diam., 28 ins. in the ground, mkd. RS33.

Thence

N. 0° 14' E., on N. and S. center line of NW.  $\frac{1}{4}$  of sec. 36.

Along a substantial fence which crosses and re-crosses line.

19.73 The W. 1/16 sec. cor. of secs. 25 and 36.

From the NW $\frac{1}{16}$  sec. cor. of sec. 36

N. 89° 52' E., on the N. subdivisional line of sec. 36.

Along a straight substantial fence built along the line laid down by county surveyor about 50 years ago.

29.643 Intersect center line of Kubli Road, as constructed, bears N.73°33'E. and S.73°33'W.

Set an iron pipe, 3 ft. long, 1 in. diam., 42 ins. in the ground, mkd. RS33; from which

An iron pipe, 3 ft. long, 1 in. diam., set 28 ins. in the ground, for a reference monument, bears S.89°52'W., 170 lks. dist., mkd. RS33.

From the E. 1/16 sec. cor. of secs. 25 and 36

Along center line of Missouri Flat Road, as constructed, on easterly boundary line of Heston property in NW $\frac{1}{4}$  of NE $\frac{1}{4}$  of sec. 36

S. 0°50'W., 10.735 chs. At end of course intersect center line of Kubli Road, as constructed.

S.46°42'W., 3.54 chs. Along center line of Kubli Road, as constructed.

S.39°23'W., 5.493 chs.

S.47°49'W., 1.825 chs.

S.54°27'W., 1.13 chs.

S.73°33'W., 2.246 chs. Intersect, at end of course, the N. subdivisional line of sec. 36, at a point from which the NW $\frac{1}{16}$

T. 37 S., R. 5 W.

## Chains

A dead white oak, 18 ins. diam., bears N.72°W., 41 lks. dist., with old blazes decayed and burnt.

And new bearing trees:

A white oak, 32 ins. diam., bears S.89°E., 240 lks. dist., mkd. T37S R5W S36 RS33 BT.

A white oak, 8 ins. diam., bears S.21°W., 97 lks. dist., mkd. T37S R5W S35 RS33 BT.

At the corner point (not disturbing the 1 in. iron pipe).

Set an iron pipe, 3 ft. long, 2 ins. diam., 28 ins. in the ground, mkd. RS33.

North, bet. secs. 25 and 26.

40.78 Point for  $\frac{1}{2}$  sec. cor. of secs. 25 and 26 at proportionate distance; there is no remaining evidence of the original  $\frac{1}{2}$  sec. cor.

Set an iron pipe, 3 ft. long, 1 $\frac{1}{2}$  ins. diam., 28 ins. in the ground, mkd. RS33; from which

A Douglas fir, 20 ins. diam., bears S.78°E., 40 lks. dist., mkd.  $\frac{1}{4}$  S25 RS33 BT.

A Douglas fir, 20 ins. diam., bears N.7 $\frac{1}{2}$ °W., 16 lks. dist., mkd.  $\frac{1}{4}$  S26 RS33 BT.

81.56 The cor. of secs. 23, 24, 25, and 26, monumented with an unmarked iron rod,  $\frac{3}{4}$  in. square, 6 ins. above ground, firmly set; from which the only extant original bearing trees

A black oak, 16 ins. diam., bears N.30°E., 53 lks. dist., with blaze healed.

A charred black oak stump, 16 ins. diam., bears N.55°W., 55 lks. dist., with no marks remaining.

And a new bearing tree

A Douglas fir, 20 ins. diam., bears N.54 $\frac{3}{4}$ °W., 79 lks. dist., mkd. T37S R5W S23 RS33 BT.

The cor. of secs. 19, 24, 25, and 30, on E. bdy. of Tp., is monumented with an unmarked iron pipe, 2 ins. diam., 4 ins. above ground, firmly set; from which the extant original bearing trees

A black oak, 16 ins. diam., bears S.58°E., 68 lks. dist., with blaze healed.

A white oak, 10 ins. diam., bears S.45°W., 54 lks. dist., with blaze partially healed.

A dead black oak, 28 ins. diam., bears N.50°W., 47 lks. dist., mkd. T37S R5W S24 BT.

Thence

N. 89° 42' W., bet. secs. 24 and 25.

40.53 Point for  $\frac{1}{2}$  sec. cor. of secs. 24 and 25, at proportionate distance; there is no remaining evidence of the original  $\frac{1}{2}$  sec. cor.

Set an iron pipe, 3 ft. long, 1 $\frac{1}{2}$  ins. diam., 28 ins. in the ground, mkd. RS33; from which

## TOWNSHIP 37 SOUTH, RANGE 5 WEST, WILLAMETTE MER., OREGON

## Dependent Resurvey of Portion of the Subdivision.

Chains

The locus of the E. 1/16 sec. cor. of secs. 25 and 36 was fixed by the county surveyor in 1905, and has been preserved and locally accepted as a point determined at the intersection of projection of property fence lines with the center line of Missouri Flat Road.

At the corner point,

Set an iron pipe, 3 ft. long, 1 in. diam., 42 ins., in the ground, mkd. RS33; from which

An iron pipe, 3 ft. long, 1 in. diam., set 28 ins. in the ground, bears S. 89° 54' W., 27.8 lks. for a reference monument, mkd. RS33.

The geographic position of this corner is latitude 42° 19' 03" N., and longitude 123° 14' 06" W. The observed magnetic declination is 20° 00' E.

July 23, 1954: at this 1/16 sec. cor., at 8 a.m. app.t., or 8h19ml9s a.m. by my watch which reads correct 120th Meridian Time, I set off 42° 19' N. on the lat. arc, 20° 07' N. on the decl. arc of my Gurley solar compass and determine a meridian with the solar attachment which is in perfect adjustment. Further solar observations were taken at each station along each line.

Thence

S. 89° 54' W., bet. secs. 25 and 36.

Along a straight well established old fence line.

20.161 The  $\frac{1}{4}$  sec. cor. of secs. 25 and 36, the locus of which has been perpetuated and locally accepted at the corner of fences bearing N., E., and W. No evidence of the original corner monument remains. I mark a new bearing tree as follows:

A white oak, 14 ins. diam., bears N. 53 $\frac{1}{4}$ ° W., 106 lks. dist., mkd.  $\frac{1}{4}$  S25 RS33 BT.

Against S. side of fence corner post, 1 lk. S. of true corner point, set an iron pipe, 3 ft. long, 1 $\frac{1}{2}$  ins. diam., 28 ins. in the ground, mkd. RS33.

S. 89° 39' W., beginning new measurement.

Along an old fence which gradually leaves the line.

20.044 Point for W. 1/16 sec. cor. of secs. 25 and 36 at proportionate distance; there is no remaining evidence of the 1/16 sec. cor. established by the county surveyor in 1905.

Set an iron pipe, 3 ft. long, 1 in. diam., 28 ins. in the ground, mkd. RS33; from which

A white oak, 18 ins. diam., bears S. 34° W., 21 lks. dist., mkd. RS33 by my brass identification washer, nailed to tree at breast height.

A Douglas fir, 12 ins. diam., bears N. 75 $\frac{1}{2}$ ° W., 43 lks. dist., mkd. W 1/16 S25 RS33 BT.

40.088 The cor. of secs. 25, 26, 35, and 36, monumented with an iron pipe (unmarked) 1 in. diam., 4 ins. above ground, firmly set; from which the only extant original bearing tree