


SCALE 1"=50'

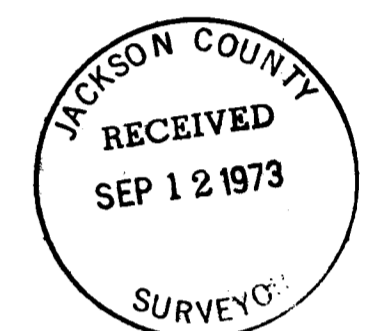

Basis of Bearings :
R.S. No. 5281

- = Fd. 5/8" I. Pin (tagged R.L.S. 638)
- = Set 5/8" I. Pin (tagged R.L.S. 638)

REGISTERED
PROFESSIONAL
LAND SURVEYOR
George Burrell
OREGON
JULY 10, 1964
GEORGE R. BURRELL
638

MAP OF SURVEY

Located in Sec. 34, T38S, R2E
For: RAY MITCHELL
ASHLAND, OREGON
By: Geo. Burrell Surveyor
Sept. 1973

SURVEY NARRATIVE TO COMPLY WITH O.R.S. 209.250

FOR: Ray Mitchell
8000 Dead Indian Rd.
Ashland, Oregon

PURPOSE: To monument and describe the tract as shown on the accompanying map (a revision of the Northerly and Westerly Boundaries of the tract established by Recorded Survey No. 5281).

PROCEDURE: In as much as the tract established by Recorded Survey No. 5281 was not conveyed, and the client wished to change said boundaries, I reestablished said boundaries according to clients instructions using the control of Recorded Survey No. 5281.

