

SCALE 1"=400'

Basis of Bearings: R.S. No. 5242

LEGEND

- ⊙ = Fd. Gov't. Cor. reestablished by Co. Surveyor
- ⊕ = Set Section Cor. Monument as noted
- = Set 5/8" x 30" Iron Pin (tagged R.L.S. 638)

PROPORTIONAL COR. POSITION  
 Set 2 1/2" dia. Brass disc in top of  
 4" x 4" x 24" Conc. Monument

REGISTERED  
 PROFESSIONAL  
 LAND SURVEYOR  
*George Burrell*  
 OREGON  
 JULY 10, 1964  
 GEORGE R. BURRELL  
 838

JACKSON COUNTY  
 RECEIVED  
 SEP 12 1973  
 SURVEYOR


**MAP OF SURVEY**  
 Located in Section 17, Twp 39S, R2E  
 For: BEN GERWICK ASHLAND, OR.  
 By: Geo. Burrell, Surveyor Aug. 1973

## SURVEY NARRATIVE TO COMPLY WITH O.R.S. 209.250

FOR: Ben Gerwick  
c/o Jim Miller  
975 Dead Indian Rd.  
Ashland, Ore.

PURPOSE: To monument the corners and mark the lines of the Northeast Quarter of the Northeast Quarter of Section 17, Township 39 South, Range 2 East.

PROCEDURE: All section corners controlling the subdivision of said section were tied to utilizing a HP-3800 distance meter and a Wild T-2 Theodolite. From coordinate data thus derived the section corner common to Sections 16, 17, 20 and 21 was computed on a double proportion basis and monumented as shown on the accompanying map. Positions were then computed for the Northeast Quarter of the Northeast Quarter and were then established on the ground from said control positions. No original evidence was found for the corner to Sections 16, 17, 20 and 21, nor was any found for the East, North and South 1/4 Corners of Section 17, thus their positions were computed on a proportional basis.

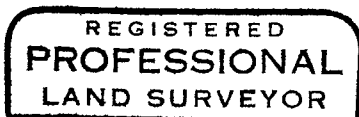

*George R. Burrell*

