
5363

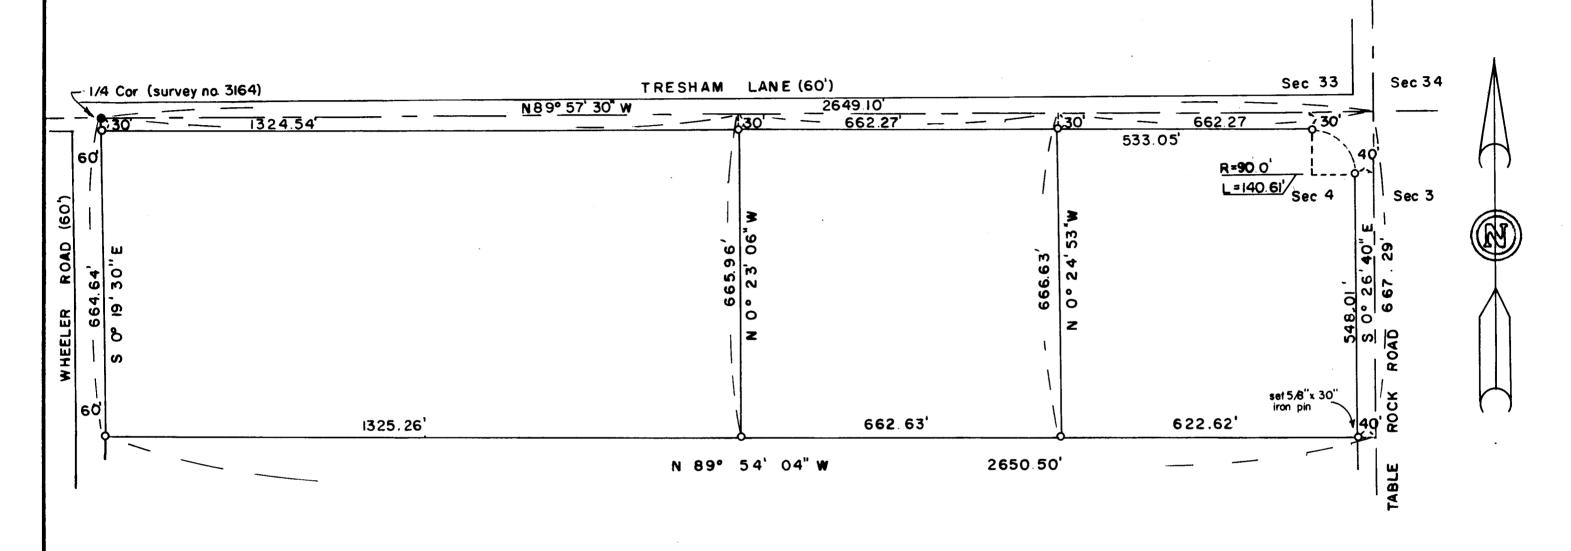

## SURVEY in NE 1/4, Sec. 4, T 36 S, R2W, W. M.

for

PETE LORENO

73-25

By Edward A. McGinty

Scale 1" = 200'

June 1973

Medford Oregon

0 = 5/8" x 24" iron pin

● = Found I iron pipe

SURVEYOR

RECEIVED

SEP 1 9 1973

PROFESSIONAL
LAND SURVEYOR

OREGON
JULY 10, 1983
EDWARD A. MCGINTY

SURVEY 1	NO.	_5363
----------	-----	-------

## SURVEY NARRATIVE TO COMPLY WITH O.R.S. 209-250

SURVEY FOR:

Pete Loreno

14350 Von Owen St.

Von Nugsi, California 91405

SURVEY BY:

Edward A. McGinty, R.S.

Medford, Oregon September, 1973

LOCATION:

N. 1/2 of the N.E. 1/4 of Sec. 4, T36S, R2W

BASIS OF BEARING:

Survey No. 3164

## PRECEDENCE OF SURVEY:

By utilizing previous survey No. 3164, computed the subdivision of the Northeast quarter corner and divided tract as shown.

- (A) N.E. Corner of Section 4, set reference from East. Found R.P.'s, now 30.02 feet N.89°50'E. and 99.99 feet.
  - (B) Found 1" pipe at 1/4 corner 1.8 feet deep.

Table Rock right of way was from the County Road data with exception of return curve on Tresham Lane, which was recommended by the County Road Dept. Could find no datum so it was staked according to existing conditions.

SURVEYOR

REGISTERED PROFESSIONAL LAND SURVEYOR

OREGON
JULY 10, 1953
EDWARD A. McGINTY