


5367

SURVEY FOR
HUTCHINS & CLARKE CONSTRUCTION COMPANY
AND
CHARLES SHINN

S.E. 1/4 SEC. 24, T. 37 S., R. 2 W., W.M.
MEDFORD, OREGON

August, 1973

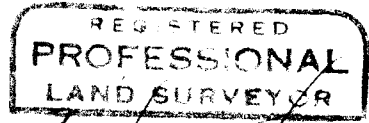


Verlyn Thomas
OREGON
MAY 13, 1960
VERLYN D. THOMAS
505



SCALE 1" = 50'

- 5/8x24" l. Pin Set
- Monument Found

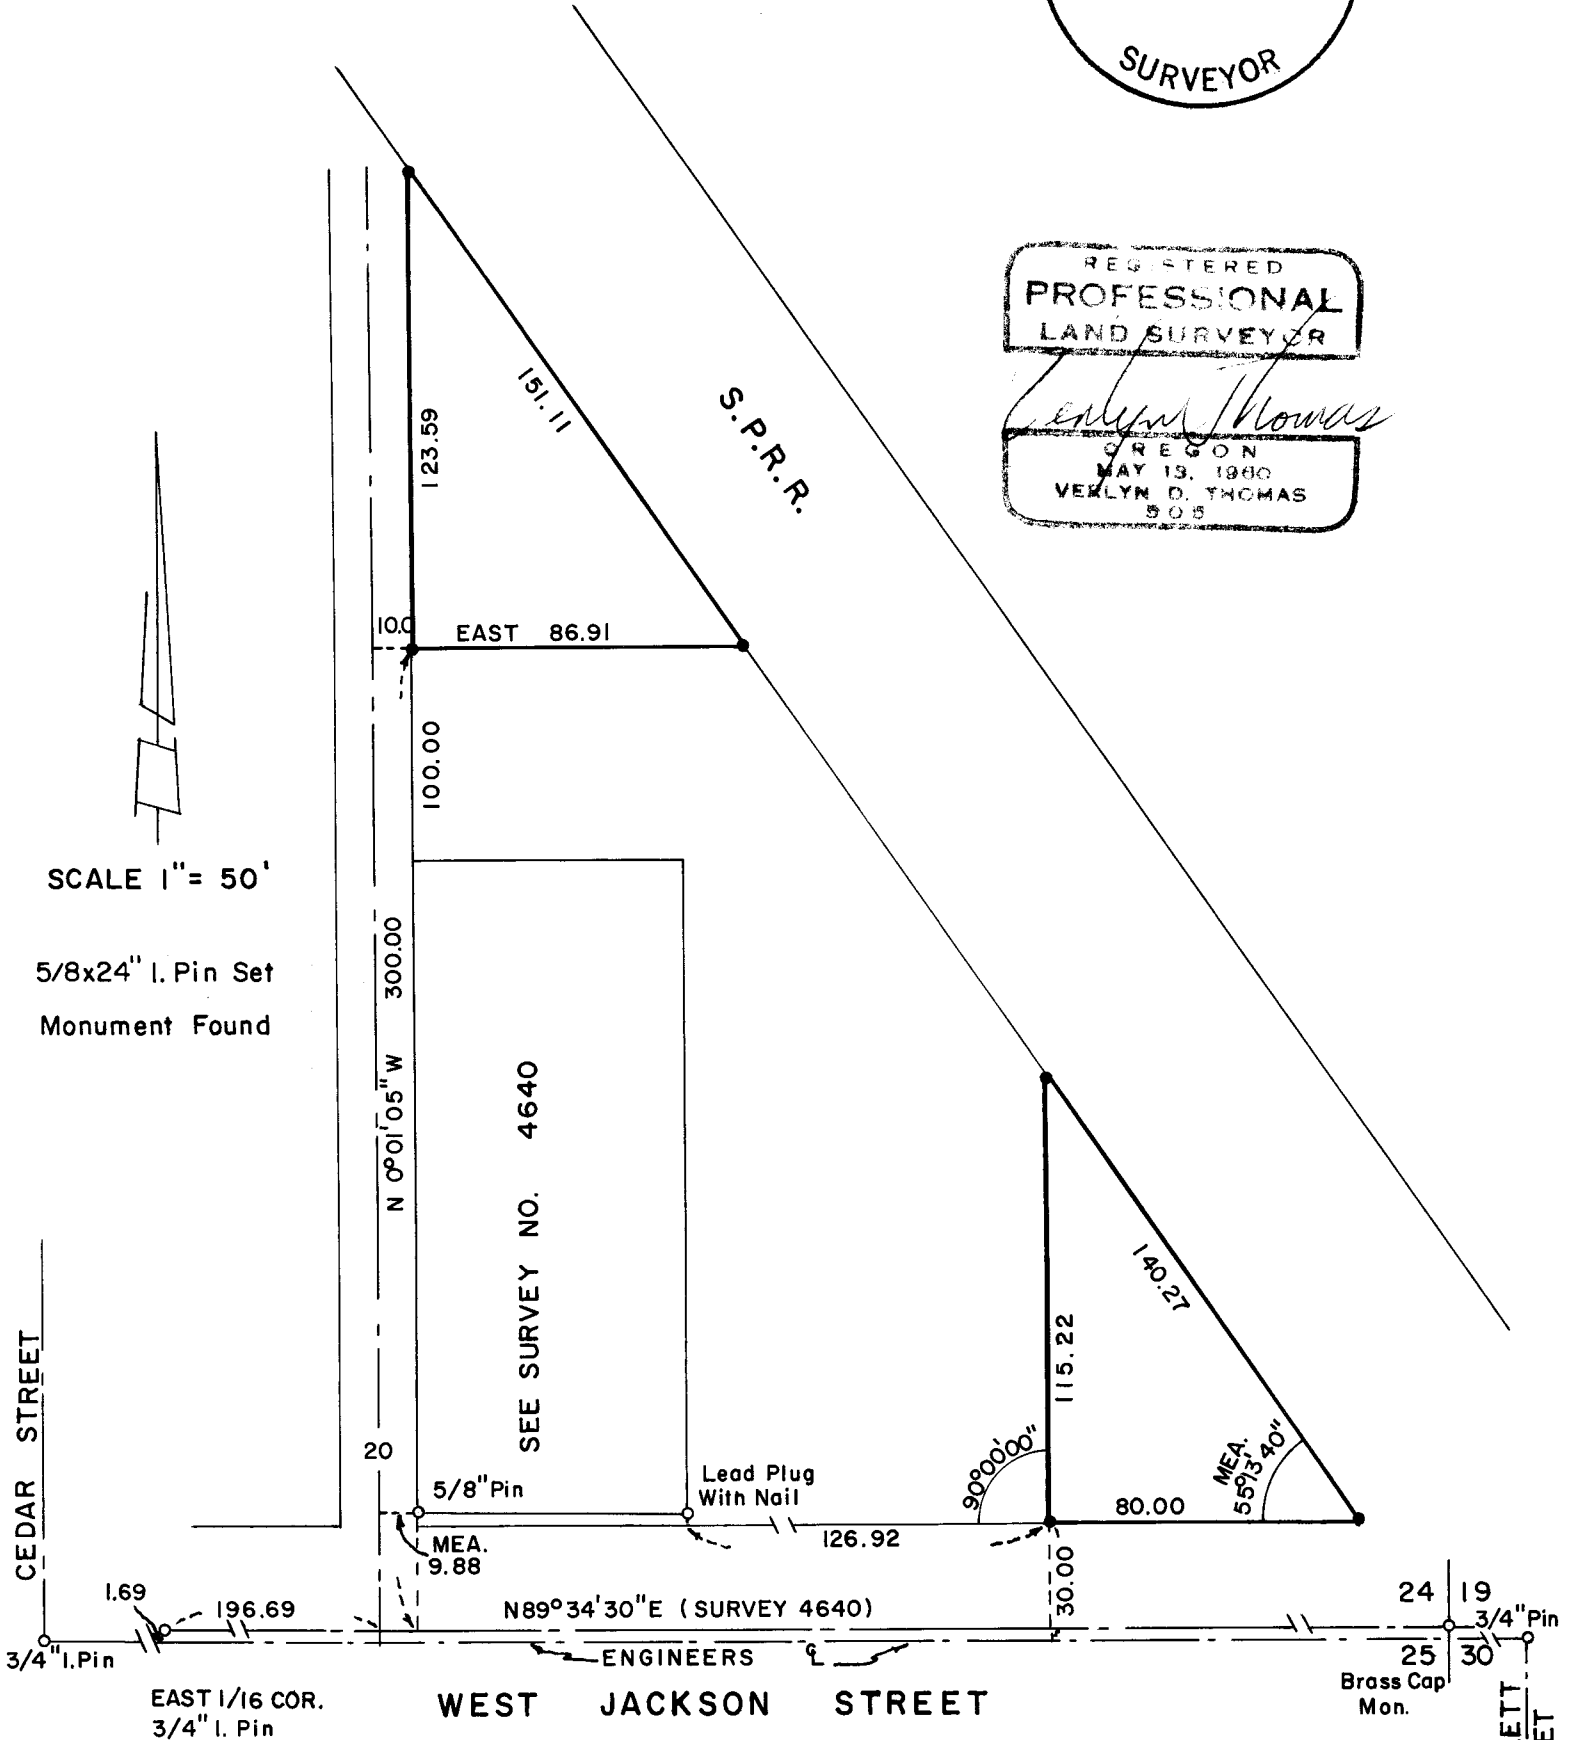

BARTLETT STREET

