


5373
1/4 SEC. COR.
32 FD. STONE
WITH LEAD PLUG

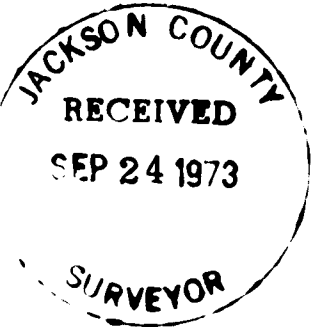

628.37 (REC. 628.15')

STERLING ST.

"N" STREET

FD 5/8" PIN

589°34'52" W — 630.07' (REC 589°35'00" W)

FD 3/4" PIN

SURVEY NO. 2990

SURVEY NO. 3144

FD 5/8" PIN

3RD STREET

SURVEY NO. 4910

FD 5/8" PIN

N 89° 35' 00" E

337.10'

180.00'

LOT 27
HOLMAN ADDN.

N 00° 25' 00" W

77.00'

147.34'

83.65'

112.55'

S 22° 34' 20" W

82.00'

40'

83.45'

431.54'

N 22° 34' 20" E

89.08'

83.45'

431.54'

83.45'

431.54'

589°35'00" W — 433.95'

FD 5/8" PIN

30'

30'

SURVEY NO. 1869

199.00' (REC 198.00')

N 00° 02' 46" W — 2653.34' (REC 2653.32')

REGISTERED PROFESSIONAL LAND SURVEYOR

Larry J. Friar

OREGON
JULY 16, 1971
LARRY J. FRIAR
961

AUGUST 27, 1973

SCALE 1" = 100'

● = SET 5/8" IRON PIN

MAP OF SURVEY

FOR

DON C. STROH

LOCATED IN

LOT 27 HOLMAN ADDITION
TO THE CITY OF JACKSONVILLE

NW 1/4 SEC 32 T. 37S, R. 2W. W.M.

SURVEYED BY LARRY J. FRIAR PLS 961

142 N IVY ST. MEDFORD, OREGON

BASIS OF BEARING SURVEY NO. 3438

31 32

SEC. COR.
FD. 1/2" IRON PIPE

6 5

5373

5373

SURVEY NARRATIVE TO COMPLY WITH PARAGRAPH 209, 250, O. R. S.

SURVEY FOR: Don C. Stroh
1301 Fortune Street
Medford, Oregon

LOCATION: South West ($\frac{1}{4}$) Section 32, Township 37 South,
Range 2 West, Willamette Meridian, Jackson
County, Oregon. Lot 27 Holman Addition to
Jacksonville, Oregon.

SURVEY BY: Larry J. Friar, P.L.S. 961
August, 1973

BASIS OF BEARING: Survey No. 3438

PURPOSE: To Monument and Describe Two Parcels as
shown on attached map.

PROCEDURE: Found and used Monuments shown on attached
map for control.

The 5/8" Pin Set in Survey No. 2990 and found
in this Survey checked very closely with
proportinate distance and was held as the
North West Corner of Lot 27 of Holman Addition.

The West line of Lot 27 was proportioned on
the basis of 2640 feet as indicated by the
Plat of Holman Addition and the Distance
measured between the South West Corner and
the West ($\frac{1}{4}$) Corner of Section 32.

