


MAP OF SURVEY
 FOR
 EVAN KUBLI

LOCATION
 NE 1/4 SECTION 7 T38S R4W W.M.
 JACKSON CO. OREGON
 SCALE 1" = 200' DATE SEPT. 1973
 BASIS OF BEARING SURVEY NO. 4482
 SURVEY BY LARRY J. FRIAR PLS 961

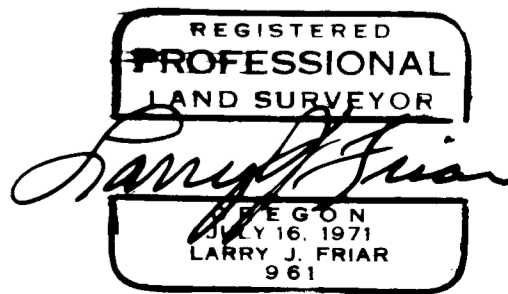

- SET 5/8" I. PIN
- FD. 1/2" I. PIPE WITH METAL DISC



SURVEY NO. 5392

SURVEY NARRATIVE TO COMPLY WITH PARAGRAPH 209, 250. O. R. S.

SURVEY FOR: Evan Kubli
15075 North Applegate Road
Grants Pass, Oregon

LOCATION: North East $\frac{1}{4}$ Section 7, Township 38 South,
Range 4 West, Willamette Meridian, Jackson
County, Oregon.

SURVEY BY: Larry J. Friar, P. L. S. 961
September, 1973

PURPOSE: #1 To Monument and Describe 1 Acre Parcel
shown on attached map. #2 To Set Corners
on fractional Section Lines of the East $\frac{1}{4}$
of the N. W. $\frac{1}{4}$ of the N. E. $\frac{1}{4}$ of Section 7,
at the South Side of the County Road. # 3 To
set the C-W- N. E. 1/64 Corner of Section 7.

PROCEDURE: Section 7 was previously subdivided by Survey
No. 4482. I recovered the monuments and ran
a traverse from the North $\frac{1}{4}$ Corner (Witness
Corner) Section 7 through the North 1/16 Corner,
the East $\frac{1}{4}$ Corner and the C-E 1/16 Corner, using
E. D. M. Equipment. The Bearings & Distances
returned verify the information shown by that
Survey.

Using the information thus verified I Subdivided
the N. E. $\frac{1}{4}$ of Section and Set Monument as shown
on the attached map.

Larry J. Friar
Professional Land Surveyor

