

SURVEY NARRATIVE TO COMPLY WITH PARAGRAPH 209.250
OREGON REVISED STATUTES

SURVEY FOR: Mr. Duane McKinnon
46 Orr Drive
Central Point, Oregon

LOCATION: Tract situate in the Southwest One Quarter (1/4),
Section 25, Township 36 South, Range 2 West,
Willamette Meridian, Jackson County, Oregon.


PURPOSE: To locate, monument and describe the tract shown on
the attached map.

PROCEDURE: Utilizing control established by Recorded Survey No.
1263, the property corners were set as indicated on the attached
map.

Basis of Bearings - Recorded Survey No. 1263.

October 8, 1973

J. A. Hoffbuhr
Professional Land Surveyor

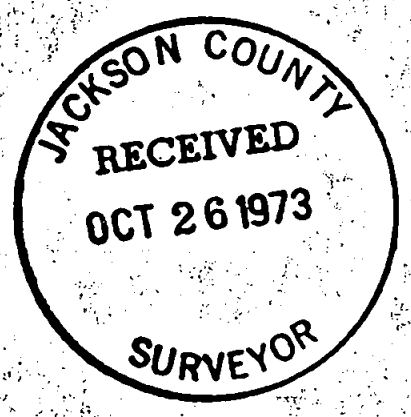

J. A. Hoffbuhr

