

5457

Survey For:
WHITE CITY CORP.
Located in the West Half of
Sec. 17 and the East Half of
Sec. 18, T. 36 S., R. 1 W., W.M.
By: Mark E. Boyden
Nov. 27, 1973

7 8
18 17
Sec. Cor.
C. S. Br. Disk
in Mon. Case


Most Northerly line of tract
described in Deed Vol. 308,
Page 469 and as monumented
on Recorded Survey No. 116



SCALE: 1" = 100'

- found 3/4" iron pin flush unless otherwise indicated
- set 3/4" x 30" iron pin flush unless otherwise indicated

BASIS OF BEARINGS:
Recorded Survey No. 4097

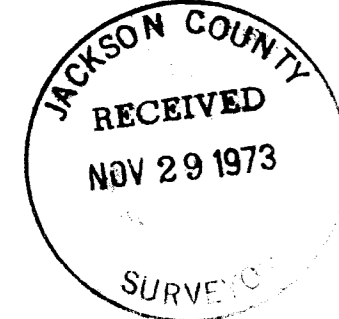

Recorded Survey
No. 5142

18 17
19 20
Sec. Cor.
Lead/Tack in Conc. Pavmt

REGISTERED
PROFESSIONAL
LAND SURVEYOR
Mark E. Boyden
OREGON
NOV. 9 1981
MARK E. BOYDEN
281

5457

SURVEY NARRATIVE TO COMPLY WITH O.R.S. 209.250

FOR: White City Corporation
White City, Oregon

PURPOSE: To monument and describe two tracts proposed to be conveyed, being located in Sections 17 and 18, T36SR1W, W.M.

PROCEDURE: Utilizing a one-second theodolite, an electronic measuring instrument and chain, tied to monuments previously found or set on Recorded Survey Nos. 116, 3700, 4097, 4304, 4305 and 5142, as shown on the map to accompany this report. From said data, computed the positions of the tract corners and then monumented same at positions as shown on said map.

November 27, 1973

