


MAP OF SURVEY  
 LOCATED IN  
 N. E. 1/4 OF SECTION 19, T. 36 S., R. 1 W., W.M.  
 JACKSON COUNTY OREGON  
 FOR  
**REICHOLD CHEMICALS, INC.**

J. A. HOFFBUHR, REG. L.S., MEDFORD, OREGON  
 SCALE: 1"=100' DEC. 11, 1972  
 BASIS OF BEARING R/S NO. 2013  
 ■ = SET BRASS DISK IN CONCRETE MONUMENT

REGISTERED  
**PROFESSIONAL**  
 LAND SURVEYOR

*J. A. Hoffburr*

OREGON  
 NOV 19 1972  
 J. A. HOFFBUHR  
 242

 

300' 11' 40" E 639.36' (REC.)

1/4 SECTION CORNER  
 FOUND BRASS DISK IN  
 IN MONUMENT CASE

SURVEY NARRATIVE TO COMPLY WITH PARAGRAPH 209.250  
OREGON REVISED STATUTES

SURVEY FOR: Reichhold Chemicals, Inc.  
P. O. Box 1482  
Tacoma, Washington

LOCATION: Tract situated in the Northeast One Quarter (1/4) of  
Section 19, Township 36 South, Range 1 West, Willamette  
Meridian, Jackson County, Oregon.

PURPOSE: To locate, remonument, and describe the parcels of  
land as shown on the attached map.

PROCEDURE: Utilized control established by Recorded Survey Nos.  
2628, 3917, 4712, and 2013 to set corners as indicated on the attached  
map.

Basis of Bearings--Recorded Survey No. 2013.

November 30, 1973

J. A. Hoffbuhr  
Professional Land Surveyor

REGISTERED  
PROFESSIONAL  
LAND SURVEYOR

*J. A. Hoffbuhr*

OREGON  
NOV. 7, 1947  
J. A. HOFFBUHR  
222

JACKSON COUNTY  
RECEIVED  
NOV 30 1973  
SURVEYOR