


MAP OF SURVEY
 FOR
Robert T. Kirkwood & Leonard J. Marshall
 Located in
 The S.E. 1/4 of Sec. 34, T. 35 S., R. 4 W., W.M.
 Jackson Co., Oregon
 Scale: 1"=100' DEC. 11, 1973
 Basis of Bearing Survey No. 4562
 Survey By: L. J. Friar P.L.S. 961

- Set 5/8" iron pin
- Fd. 5/8" iron pin
- Set 5/8" X 30" iron pin

REGISTERED
 PROFESSIONAL
 LAND SURVEYOR
 OREGON
 JULY 16, 1971
 LARRY J. FRIAR
 961

JACKSON COUNTY
 RECEIVED
 DEC 21 1973
 SURVEYOR

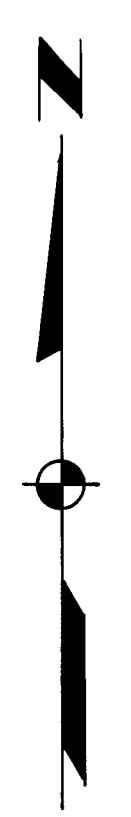

FD. CO. SURVEYOR'S
 BRASS CAP MON

FD. CO. SURVEYOR'S
 BRASS CAP IN
 CON. MON.

- 3498
5498

SURVEY NARRATIVE TO COMPLY WITH PARAGRAPH 209. 250 O. R. S.

DATE: December 14, 1973

SURVEY FOR: Robert T. Kirkwood and Leonard J. Marshall
2184 East Evans Creek Road
Rogue River, Oregon

LOCATION: S. E. $\frac{1}{4}$ of Section 34, Township 35 South, Range
4 West, Willamette Meridian, Jackson County,
Oregon.

PURPOSE: To divide property into tracts and monument as
shown on the attached Map.

PROCEEDURE: Ran closed traverse around the Southeast $\frac{1}{4}$ of
Section, tying monument set on previous Surveys
Numbers 3838, 3435, 4562, 4606 and 5447.

I then tied to the Northeast Corner, the Northwest
Corner and the West $\frac{1}{4}$ Corner of Section 34 and
computed the location of the North $\frac{1}{4}$ Corner, and
the Center $\frac{1}{4}$ Corner.

Found $\frac{5}{8}$ inch iron at the North $\frac{1}{4}$ Corner to be
in error, contacted the Surveyor who Set the pin
and he said that he would re set it in the correct
location.

Monuments found and set are shown on the attached
Map.

E. D. M. equipment and a one second Theodolite
was used on this Survey.

Larry J. Friar
Professional Land Surveyor

