
SURVEYOR

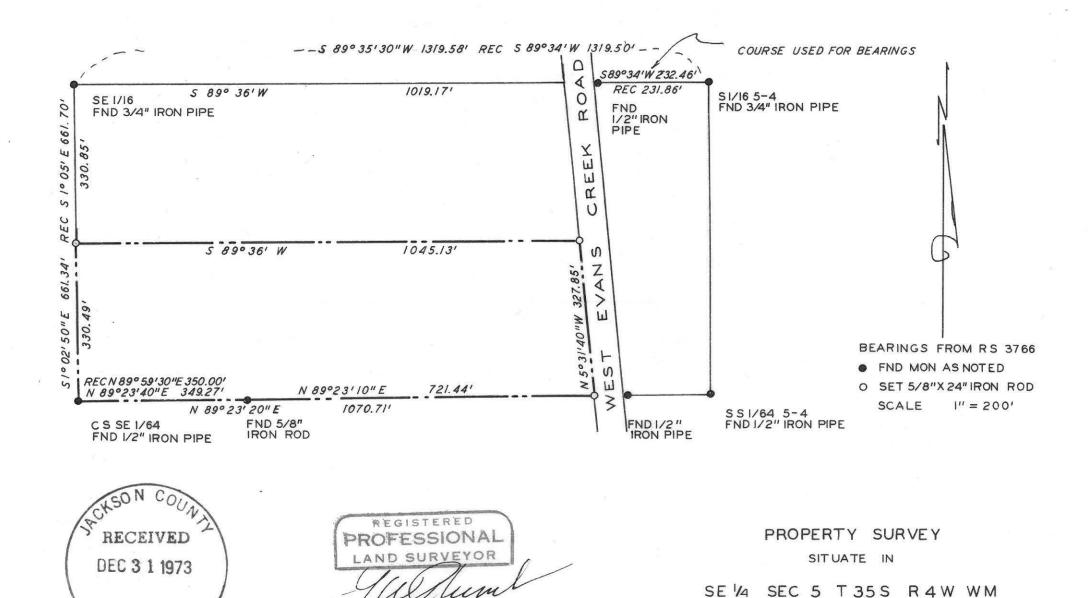

REGON JULY 12, 1968 G. W. PLUMB

862

G W PLUMB LAND SURVEYOR
MEDFORD OREGON 20 DEC 1973

JACKSON COUNTY OREGON

Survey for

Nick Bolen

6450 Myrtlewood Brive

San Jose, California 95129

Survey by

G. W. Plumb Land Surveyor

P. O. Box 904

Medford, Oregon 97501

Location

SE4 Section 5, T. 35 S., R. 4 W., W.M., Jackson

County, Oregon

Found 3/4 inch iron pipes with witness trees as described in Registered Survey No. 3766, for the South 1/16th corner of Sections 5 and 4, and for the Southeast 1/16 corner of Section 5. Found 1/2 inch iron pipes with witness trees per same Survey for the South South 1/64th corner of Sections 5 and 4, and for the Center South Southeast 1/64th corner of Section 5. Found 1/2 inch iron pipes set per Registered Survey No. 3766 for the intersection of the North and East-West center lines of the SE_4^1 of the SE_4^1 of Section 5 with the easterly right of way line of West Evans Creek Road, as it existed in 1968. Although these points are not exactly on the lines between the respective external corners of the sixteenth section, their positions were used, to avoid changing the locations which had been accepted as property corners since the completion of the registered survey. Found 5/8 inch iron rods marking the westerly right of way line of the county road as re-constructed. Set 5/8 inch iron rods, 24 inches long, to mark the corners of property per description furnished by owner.

27 December 1973

REGISTERED PROFESSIONAL SURVEYOR

> 1968 12. PLUMB

m

DEC 3 1 1973

SURVEYOF