

REGISTERED
PROFESSIONAL
LAND SURVEYOR

Everett L. Swain

OREGON
JULY 8, 1966
EVERETT L. SWAIN
759



MAP OF SURVEY
LOCATED IN
SEC. 10, TWP. 39S., R. 1 E. W. M.
FOR

WILLIAM A. STACY

EVERETT L. SWAIN, R.L.S.

ASHLAND, OREGON

SCALE: 1" = 100'
BASIS OF BEARING

JULY 2, 1973
U.S.C. & G.S. TRUE BEARING N-S & SEC. 10

- FOUND MONUMENTS AS SHOWN
- SET 5/8 x 24 INCH IRON PIN TAGGED R.L.S. 759

SURVEY NARRATIVE TO COMPLY WITH PARAGRAPH 209.250
OREGON REVISED STATUTES

SURVEY FOR: William A. Stacy
1980 East Main Street
Ashland, Oregon 97520



LOCATION: Situated in Section 10, Township 39 South, Range 1 East of the
Willamette Base and Meridian, Jackson County, Oregon.

PURPOSE: To survey, monument and prepare a legal description for that parcel
of land as shown on the accompanying map.

PROCEDURE: Found the stone for the Southeast corner of Tract 47, Ashland Acres
Subdivision being somewhat Westerly of the East line of Donation
Land Claim No. 45. Held said stone as per Instrument No. 67-10606
to locate this survey. Found monuments in the area of this survey,
apparently set on an unrecorded survey. Proceeded to survey this
tract as shown on the accompanying map, per clients representative.

July 2, 1973

Everett L. Swain
Professional Land Surveyor
Ashland, Oregon

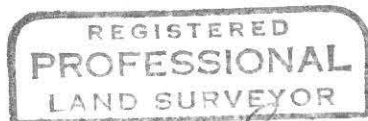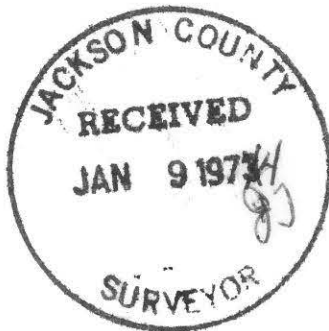

Everett L. Swain

